


KANSAS

Ellis

Section 32 Township 13 Range 17W

Well No. #1 Lang

Company Derby

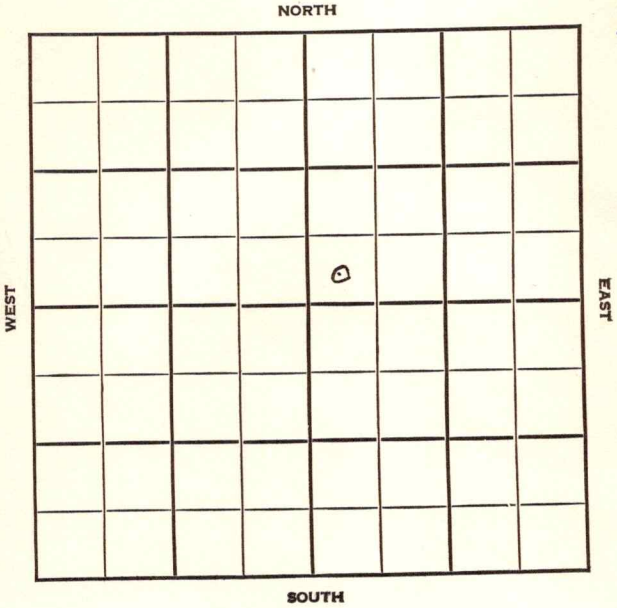

Sec. 32 Twp. 13 R. 17W

Well No. #1 Lang Farm \_\_\_\_\_


Derby Company \_\_\_\_\_

\_\_\_\_\_ Ft. from N. Line

330 Ft. from S. Line

\_\_\_\_\_ Ft. from E. Line

330 Ft. from W. Line

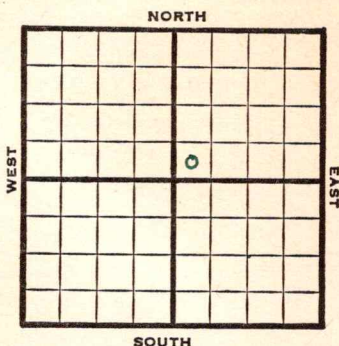

SW NE

1948 Elev. 2045' REPORT

1/14 Location

1/21 "

2/26 "

2/4 8" @ 1265'  
Drlg. 1400'

2/11 Lansing 3323'  
Drlg. 3553'

2/18 Arbuckle 3583-86'  
TD 5" @ 3584'  
RUST

2/25 "

3/3 "

3/10 "

3/17 TD 3664' SD

3/24 Arbuckle 3583'  
TD 3698'

**ABANDONED**

3323  
2045  
1278

3583  
324  
1534

Map No. \_\_\_\_\_ Sec. 32 Twp. 13 R. 17W


Well No. 1 Lang

Derby \_\_\_\_\_ Company

FIRST REPORT \_\_\_\_\_ Contractor

SW NE

SECTION PLAT

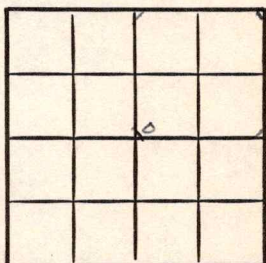

\_\_\_\_\_ Ft. from N. Line

330 Ft. from S. Line

\_\_\_\_\_ Ft. from E. Line

330 Ft. from W. Line

Ellis County

Location X

Rig up \_\_\_\_\_

Drilling and Remarks:

RECORD

Cased \_\_\_\_\_ in., \_\_\_\_\_ ft.

Sand \_\_\_\_\_

Gas \_\_\_\_\_

Oil \_\_\_\_\_

Total Depth \_\_\_\_\_

PRODUCTION

1st 24 hrs. Nat. \_\_\_\_\_

1st 24 hrs. after shot \_\_\_\_\_

Gas \_\_\_\_\_ Cu. Ft.

Dry Hole \_\_\_\_\_

Abandoned \_\_\_\_\_

Date

JAN 14 1948 19

S. J. LEWIS Scout

Map No. 71 Sec. 32 Twp. 13 R. 17W

Well No. 1 Lang

Derby Company

**ABANDONED** Contractor

SW NE

*E1.2045*  
SECTION PLAT


\_\_\_\_\_ Ft. from N. Line

330 Ft. from S. Line

\_\_\_\_\_ Ft. from E. Line

330 Ft. from W. Line

Ellis County

Location \_\_\_\_\_

Rig up \_\_\_\_\_

Drilling and Remarks:

*Curry 3583*

RECORD

Cased \_\_\_\_\_ in., \_\_\_\_\_ ft.

Sand \_\_\_\_\_

Gas \_\_\_\_\_

Oil \_\_\_\_\_

Total Depth 3698.

PRODUCTION

1st 24 hrs. Nat. \_\_\_\_\_

1st 24 hrs. after shot \_\_\_\_\_

Gas \_\_\_\_\_ Cu. Ft.

Dry Hole \_\_\_\_\_

Abandoned \_\_\_\_\_

Date

MAR 24 1948 19

S. J. LEWIS Scout