

Ellis

KANSAS

Section 33 Township 13 Range 17W

Well No. #1 Braun

Company Alpine Oil & Royalty

NORTH

						0	

SOUTH

WEST

EAST

1

Ellis

KANSAS

Sec. 33 Twp. 13 R. 17W

Well No. #1 Braun Farm

Alpine Oil & Royalty Company

Contractor


330' Ft. from N. Line

_____ Ft. from S. Line

990' Ft. from E. Line

_____ Ft. from W. Line

NW NE NE

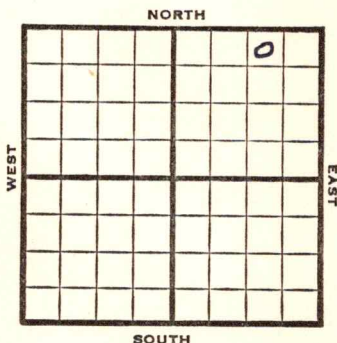

1952

Elev. 1967' REPORT

7/16

Cellar & Pits

7/23

8" @ 175'

Drilg. 2920'

7/30

Spud 7-15-52

D & A TD 3597' 8" @ 175

Heeb 3227' Lans. 3271'

DST 3430-66 open $\frac{1}{2}$ hr. rec 15' mud C#

Cong. 3588' TD 3597' D & A

ABANDONED

County **Ellis** State **Kansas**

Sec. 33 (Blk.) 13 (Sur.) 17W Map No.

Operator Alpine Oil & Royalty

Well No. 1 Farm Braun

[illegible]

County Ellis State Kansas
 Sec. 33 (Blk.) 13 (Sur.) 17W Map No.
 Operator Alpine Oil & Royalty
 Well No. 1 Farm Braun
 Elev. 1967 Location NW NE NE



330 Ft. From N Line NE
990 Ft. From E Line Quarter

1st. Report

Completion JUL 30 1952

Remarks

Spudding Date 7-15-52

Drlg. Data D & A TD 3597

8" @ 175 Heeb. 3227 Lans. 3271

DST 3430-66 open $\frac{1}{2}$ hr. Rec. 15' mud 0#

Cong. 3588 TD 3597

D & A

J. G. McGEHEE