


Ellis

Section 33 Township 13 Range 17W

Well No. 1 Weber

Company E. Adair

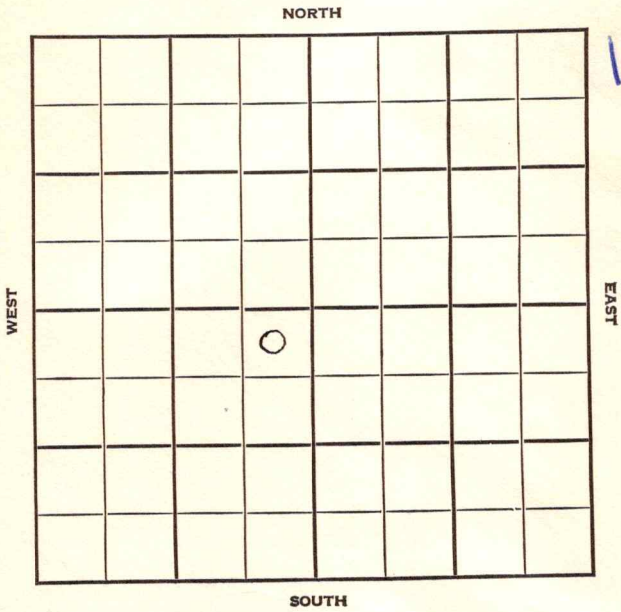

KANSAS

Ellis



Sec. 33 Twp. 13 R. 17W

Well No. #1 Weber Farm

E. Adair Company

Wildcat


330' Ft. from N. Line

_____ Ft. from S. Line

330' Ft. from E. Line

_____ Ft. from W. Line

NE SW

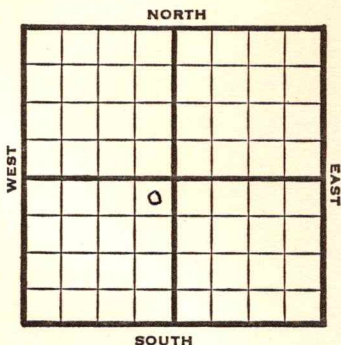

1948

Eli 2020'

R E P O R T

7/28 Drlg. 1660'

8/4 Lansing 3325'

Cong 3561'

Simpson 3575'

Arb. 3582'

TD 3610'

Ab_and.

ABANDONED

Ellis County Kansas State

Map No. _____ Sec. 33 Twp. 13 R. 17W

Well No. 1 Weber

E. Adair Company

FIRST REPORT Contractor

NE SW

SECTION PLAT

330 Ft. from N. Line

_____ Ft. from S. Line


330 Ft. from E. Line

_____ Ft. from W. Line

Wildcat

Remarks:

drlg. 1660

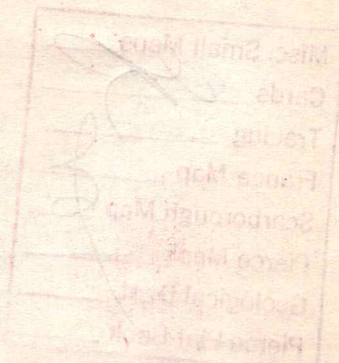

Date JUL 28 1948

Scout S. J. LEWIS

Ellis County Kansas State

Map No. 71 Sec. 33 Twp. 13 R. 17W

Well No. 1 Weber

E. Adair Company

ABANDONED

Contractor

NE SW

21.2020
SECTION PLAT

330 Ft. from N. Line

_____ Ft. from S. Line

330 Ft. from E. Line

_____ Ft. from W. Line

Wildcat

Remarks:

*Lane 3325
Cong 3561
Smig 3575
Cox 3582
773610*

Misc. Small Maps
Cards
Tracing
France Map
Scotch Map
Piece Map
Geological Dept.

Date AUG 4 1948

Scout S. J. LEWIS