


Section 17 Township 16 Range 13-W

Well No. #6, Stoskopf

Company Cities Service Oil Company

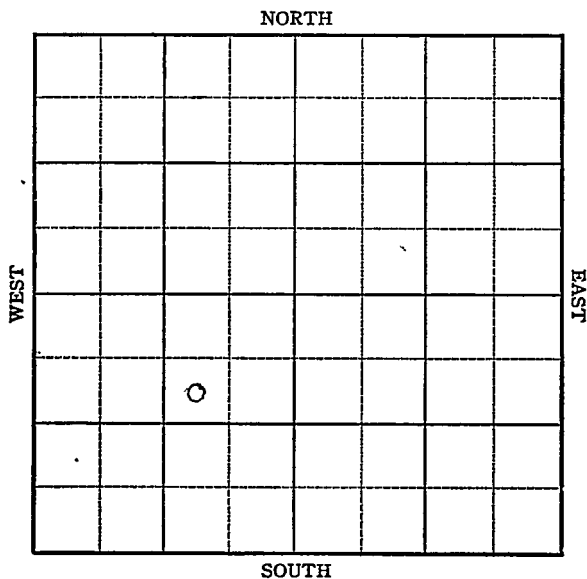

KANSAS

O. W. P. B. ✓  
Barton County

Sec. 17 Twp. 16 R. 13W

Well No. #6 Stoskopf Farm

Cities Service Company

Susank


990 Ft. from N. Line

Ft. from S. Line

Ft. from E. Line

990 Ft. from W. Line

SW NE SW

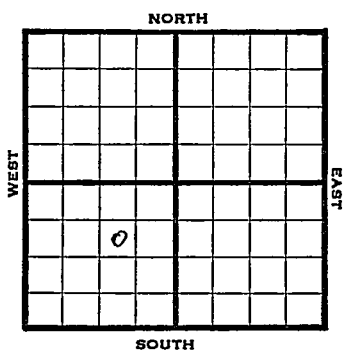

1946

Elev. 1959' REPORT

7/31

Location

8/6

"

8/13

8" @ 372  
Drlg 2125'

8/20

Drlg 3321'

8/27

Lans 3146  
Arb 3405  
5" @ 3406

9/5

TD 3413-2750' oil 16 hrs  
Arb 3405'  
TD 3413'  
5" @ 3406'  
Pump 209 Pot  
Grav 39

COMPLETED

O. W. P. B.

1951

9/12

Oil well TD 3385' Lans. 3147'  
Arb. 3405' 5" @ 3406' OTD 3413'  
Arb. prod. PB 3385' 20/3307-13  
42/3237-54 2500 A P/7 BO plus  
107 BWPD. Complete

FIRST REPORT  
↓  
COMPLETED

KANSAS

Kansas

Pool Name SusankMap No. 72 Sec. 17 Twp. 16 R. 13WWell No. 16 Stoskopf

Cities Service

Company

## FIRST REPORT

Contractor

SW NE SW

## SECTION PLAT

990 Ft. from N. Line       Ft. from S. Line       Ft. from E. Line990 Ft. from W. Line


Barton County

Location XRig up       

Drilling and Remarks:

## RECORD.

Cased        in.,        ft.Sand       Gas       Oil       Total Depth       

## PRODUCTION

1st 24 hrs. Nat.       1st 24 hrs. after shot       Gas        Cu. Ft.Dry Hole       Abandoned       

Date

JUL 3 1 1946 19S. J. LEWIS

Scout

Pool Name SusankMap No. 73 Kansas Sec. 17 Twp. 16 R. 13WWell No. 6 StoskopfCities Service Company**COMPLETED**

Contractor

SW NE SW

E. 1959  
SECTION PLAT990 Ft. from N. Line

\_\_\_\_\_ Ft. from S. Line

\_\_\_\_\_ Ft. from E. Line

990 Ft. from W. Line


Barton County

Location \_\_\_\_\_

Rig up \_\_\_\_\_

Drilling and Remarks:

Per 84055" @ 8406Pump 209 P &39° SW**RECORD**

Cased \_\_\_\_\_ in., \_\_\_\_\_ ft.

Sand \_\_\_\_\_

Gas \_\_\_\_\_

Oil \_\_\_\_\_

Total Depth 8413**PRODUCTION**

1st 24 hrs. Nat. \_\_\_\_\_

1st 24 hrs. after shot \_\_\_\_\_

Gas \_\_\_\_\_ Cu. Ft.

Dry Hole \_\_\_\_\_

Abandoned \_\_\_\_\_

Date

SEP 5 1946 19 \_\_\_\_\_S. J. LEWIS Scout

County **Barton** State **Kansas**

Sec. **17** (Blk. Twp.) **16** (Sur. Rge.) **13W** Map No.

Operator **Cities Service Oil**

Well No. **6** Farm **Stoskopf**

Elev. **1959** Location **SW NE SW**

FIRST REPORT COMPLETE 0									

990 Ft. From **N** Line **SW**  
 990 Ft. From **E** Line Quarter

1st. Report **SEP 12 1951**

Completion **SEP 12 1951**

Remarks **OWPB**  
**O. W. P. B.**

Spudding Date

Drlg. Data **Oil well TD 3385**

**Lans 3147 Arb 3405 5" 3406 OTD 3413 arb pro**

**PB 3385 20/3307-13 42/3237-54 2500A**

**P 7 BO plus 107 BWPD -- 3 Complete**

J. E. TYRA