


Ellis

KANSAS

SECTION 33 TOWNSHIP 13S RANGE 17W

WELL NO. #1 Weber

COMPANY Icer Addis

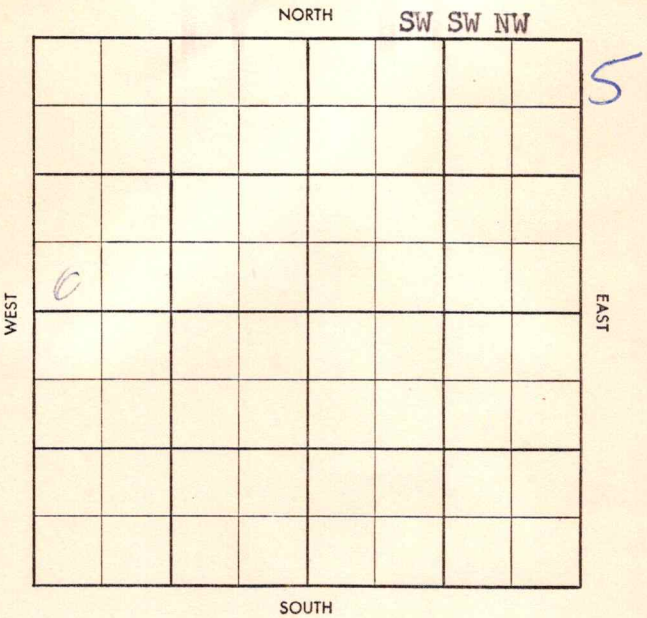

~~Section Pool~~
~~Section Pool~~

County Ellis Elev. 2031 DF
Sec. 33 Twp. 13 Rge. 17W
Company Icer Addis
Farm Name Weber No. 1

TOPS	DEPTH	LOG	DATUM
Anh.			
Tp.			
H.			
Tr.			
Dg.			
B.L.			
L.			
K.C.			
B.K.C.			
Ce.			
C.			
M.			
M.			
K.			
Mz.			
Mq.			
V.			
S.			
S.			
A.			
R.			
Pf.			
G.			
T.D.			

Loc. in Sec. SW SW NW
Geol. D. Vaughan
Contr. _____
Shields #3
Pool Sugarloaf



Date Comm. 4/7/58
8" @ 1243 Drlg. 3133.

Co.
Lse.
No.
Sec.
T.
R.

Twp. ~~A~~ Pool ~~X~~
~~X~~ Facet ~~X~~

S-513-B

County Ellis Elev. 2031 DF 903410
 Sec. 33 Twp. 13 Rge. 17W
 Company Icer Addis
 Farm Name Weber No. 1

TOPS	DEPTH	LOG	DATUM
Anh.			
Tp.			
H.	<u>3280</u>		
Tr.	<u>3301</u>		
Dg.			
B.L.			
L.	<u>3325</u>		
K.C.			
B.K.C.			
Ce.			
C.	<u>3567</u>		
M.			
M.			
K.			
Mz.			
Mq.			
V.			
S.			
S.			
A.			
R.			
Pf.			
G.			
T.D.	<u>3610</u>		

Loc. in Sec. SW SW NW
 Geol. D. Vaughan
 Contr. Shields #3
 Pool Sugarloaf

APR 23 '58
 ABANDONED

Date Comm. 4/7/58
8" @ 1243 Drlg. 3133. APR 23 '58 DST 3343
-61 @ 30" 8'M BHP 795/15
DST 3399 - 3401 @ 1hr 8'M BHP
905/15"

DBA