


Section 17 Township 29 Range 6E

Well No. ~~#114~~ 15 Fee

Company Wakefield

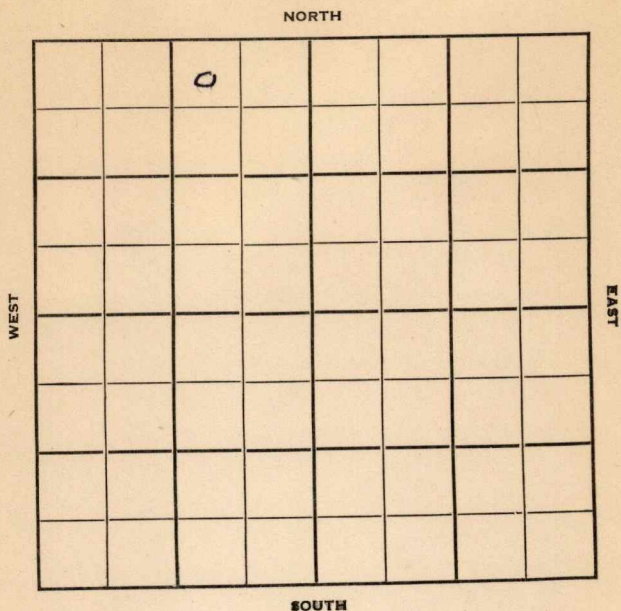

Butler

KANSAS ✓

Sec. 17 Twp. 29 R. 6EWell No. #15
#14 Fee (Wakefield) Farm

Wakefield

Company

Wakefield

Contractor

330

Ft. from N. Line


Ft. from S. Line

990

Ft. from E. Line

Ft. from W. Line

NW NE NW

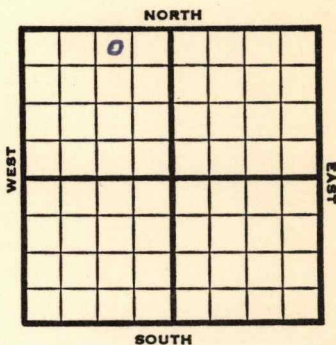

1953

Elev. 1494' REPORT

4/1

Spud 3-28-53

8" @ 95'

Drlg. 1500'

4/15

Spud 3-28-53

D & A

TD 2807'

8" @ 95'

Stal 1825, KC 2153, Bart 2785, Miss 2806,

TD 2807'

D & A

ABANDONED

County Butler State KansasSec. 17 (Blk.
Twp.) 29 (Sur.
Rge.) 6E Map No.Operator WakefieldWell No. 14 Farm FeeElev. Location NW NE NW

		0					

FIRST REPORT

330 Ft. From N Line NW990 Ft. From E Line Quarter1st. Report OCT 15 1952

Completion

Remarks

Spudding Date

Drlg. Data

10" @ 119

Kansas

Map No. Sec. 17 Twp. 29 R. 6EWell No. 15 FeeWakefield

Company

CORRECTION

Contractor

NW NE NW

SECTION PLAT

330 Ft. from N. Line Ft. from S. Line990 Ft. from E. Line Ft. from W. Line

	0		

Butler CountyLocation Rig up

Drilling and Remarks:

Reported

#14 Fee

RECORD

Cased in., ft.Sand Gas Oil Total Depth

PRODUCTION

1st 24 hrs. Nat. 1st 24 hrs. after shot Gas Cu. Ft.Dry Hole Abandoned

Date

APR 8 1953

19

J. G. McGEHEE

Scout

County Butler State Kansas
Sec. 17 (Blk.) 29 (Sur.) 6E Map No.
Operator Wakefield
Well No. 15 Farm Fee
Elev. 1494 Location NW NE NW



330 Ft. From N Line NW

990 Ft. From E Line Quarter

1st. Report

Completion APR 15 1953

Remarks

Wakefield - Contr.

Spudding Date 3-28-53

Drlg. Data D & A TD 2807

8" @ 95 Stal. 1825 KC 2153

Bart. 2785 Miss. 2806 TD 2807

D & A