


Section 5 Township 11 Range 11W

Well No. 1 Boxberger

Company Lee Phillips

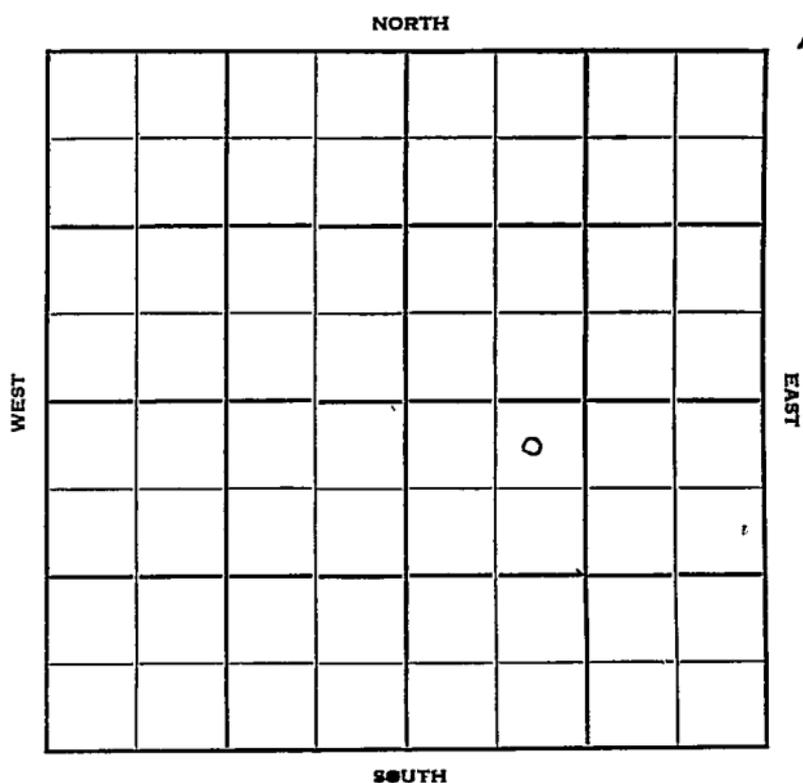

Sec. 5 Twp. 14 R. 14 W ✓

Well No. # 1 Boxberger Farm

Lee Phillips Company

Contractor


330 Ft. from N. Line

Ft. from S. Line

Ft. from E. Line

990 Ft. from W. Line

NE NW SE

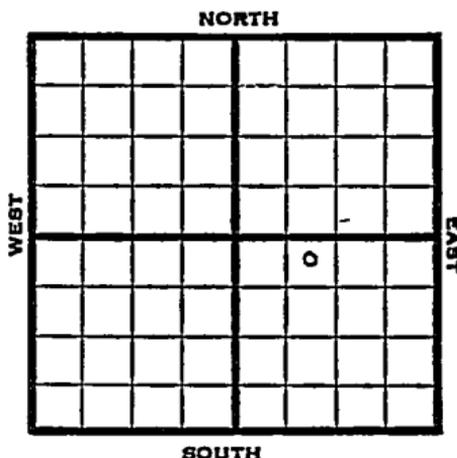

1951

Elev. 1865 REPORT

8/1

Location

9/5

Spud 8-8-51
 D&A TD 2468
 10" @ 527
 Anhy 894-932 8" @ 900
 Tarkio 2465-68 TD
 D&A

ABANDONED

County Russell State Kansas

Sec. 5 (Blk. 14) (Sur. 14W) Map No.

Operator Lee Phillips

Well No. 1 Farm Boxberger

Elev. 1865 Location NE NW SE

| | | | | | |
|--|--|--|--|--|--|
| | | | | | |
| | | | | | |
ABANDONED

330 Ft. From N Line SE

990 Ft. From W Line Quarter

1st. Report

Completion SEP 5 1951

Remarks

Spudding Date 8-8-51

Drlg. Data D & A TD 2468

10" @ 527 Anhy 894-932 8" @ 900

Tarkio 2465-68 TD

D & A