

KANSAS


FORM 51 5M 11-44 PETROL

Barton County

Section 18 Township 16 Range 13W

Well No. #1 Luerman

Company Sharon Drlg. et al

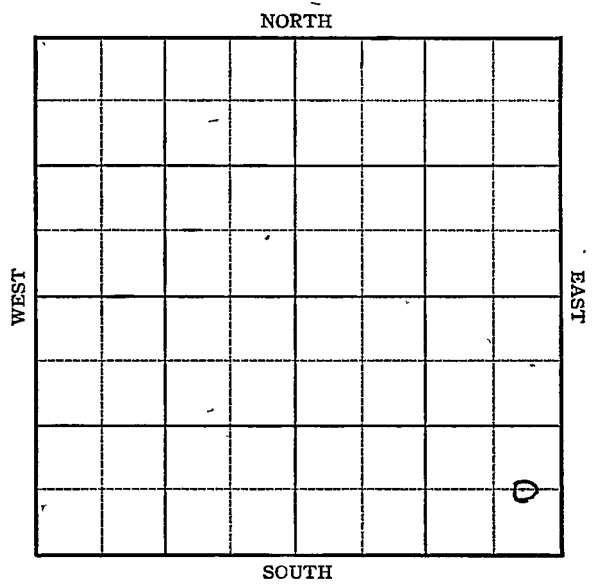

KANSAS

Barton County

Sec. 18 Twp. 16 R. 13W

Well No. #1 Luerman Farm

Sharon Drlg. et al Company

Susank


 Ft. from N. Line

660 Ft. from S. Line

330 Ft. from E. Line

 Ft. from W. Line

CEL SE SE

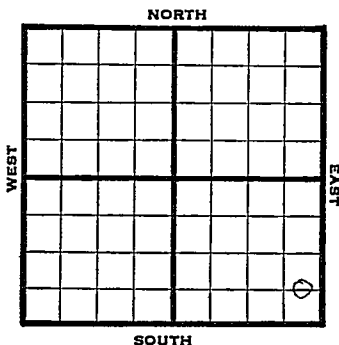

1946 Elev. 1950 REPORT

6/26 Location
7/3 10" @ 160
Anhy 900' Topeka 2836
Drlg 2857'
7/9 Lans 3150'
Arb 3382'
5" @ 3383
Drlg 3391 V SSO
7/17 Arb. 3382
5" @ 3383
TD 3420
500 acid.
Pump 30 oil plus 10 Wtr. Pot.
Grav. 39.0

COMPLETED

KANSASKansas Pool Name SusankMap No. 73 Sec. 18 Twp. 16 R. 13WWell No. 1 LuermanSharon Drlg. etal. Company**FIRST REPORT**

Contractor

C E L SE SE

SECTION PLAT

 Ft. from N. Line660 Ft. from S. Line330 Ft. from E. Line Ft. from W. LineBarton CountyLocation XRig up

Drilling and Remarks:

RECORDCased in., ft.Sand Gas Oil Total Depth **PRODUCTION**1st 24 hrs. Nat. 1st 24 hrs. after shot Gas Cu. Ft.Dry Hole Abandoned

Date

JUN 26 1946 19S. J. LEWIS

Scout


KANSAS

Pool Name Susank PoolMap No. 23 Sec. 18 Twp. 16 R. 13WWell No. 1 LuermanSharon Drlg. etal. Company

COMPLETED

Contractor

C E L S E S E

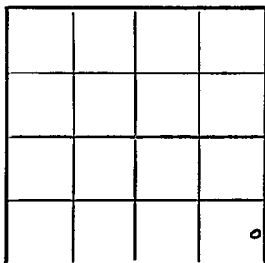E 1 / 1950
SECTION PLAT Ft. from N. Line660 Ft. from S. Line330 Ft. from E. Line Ft. from W. Line

Barton County

Location Rig up

Drilling and Remarks:

CR 733825" @ 3383500 acidPump 3000 ft + 10Watered out3792 ft

RECORD

Cased in., ft.Sand Gas Oil Total Depth 3420

PRODUCTION

1st 24 hrs. Nat. 1st 24 hrs. after shot Gas Cu. Ft.Dry Hole Abandoned

Date

JUL 17 1946 19S. J. LEWIS Scout