

Form 51-5M-7-39-Palace


Barton

Section 18 Township 16 Range 13-W

Well No. #1 Luerman

Company Sharon Drilling


NORTH Trapp South Pool

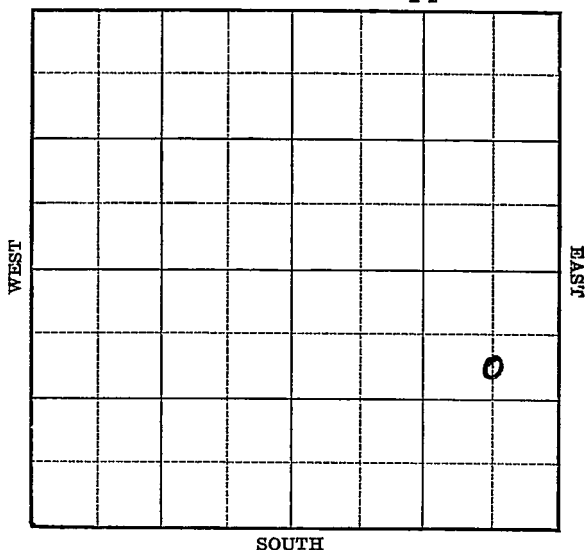

Barton **KANSAS**Map No. 73 Sec. 18 Twp. 16 R. 13WWell No. 1 LuermanSharon Drilling

Company

Contractor

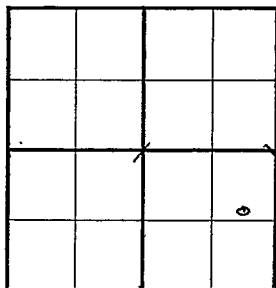FIRST REPORT
C S L NE SE990 Ft. from N. Line Ft. from S. Line660 Ft. from E. Line Ft. from W. Line**TRAPP SOUTH POOL****SECTION PLAT**Location XRig up Drilling and Remarks: **RECORD**Cased in., ft.Sand Gas Oil Total Depth **PRODUCTION**1st 24 hrs. Nat. 1st 24 hrs. after shot Gas Cu. Ft.Dry Hole Abandoned

Date

Jul 10 1919S. J. LEWIS

Scout

Map No. 73 Sec. 18 Twp. 16 R. 13WWell No. 1 LuermanSharon Drilling

Company

Contractor

COMPLETED

C S L NE SE

990 Ft. from N. Line Ft. from S. Line660 Ft. from E. Line Ft. from W. Line

SECTION PLAT

TRAPP SOUTH POOL

Location Rig up

Drilling and Remarks:

*Cur 3358.**5 1/2 "C 3358**2000 acid**Depthograph Log**3038**Maximum 3000*

RECORD

Cased in., ft.Sand Gas Oil Total Depth 3362

PRODUCTION

1st 24 hrs. Nat. 1st 24 hrs. after shot Gas Cu. Ft.Dry Hole Abandoned

Date

FEB 21 1940 19

S. J. LEWIS Scout