


O.W.W.O.

DX 78-1

Section 5 Township 11 Range 11 W

Well No. 14 Boxberger

Company Icer Addis

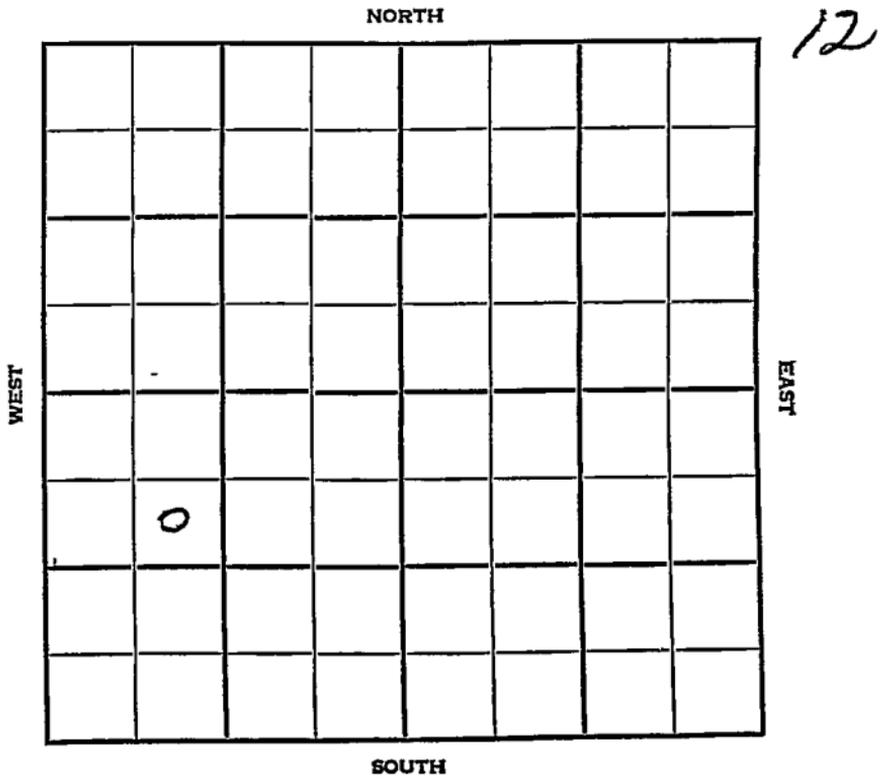

O.W.W.O.

Russell KANSAS ✓

SEC.	TWP.	R.
5	14	14W ✓

WELL NO. **4 Boxberger** FARM

COMPANY

CONTRACTOR **Icer Addis**


**Atherton Pool**

990 \_\_\_\_\_ Ft. from N. Line

\_\_\_\_\_ Ft. from S. Line

\_\_\_\_\_ Ft. from E. Line

990 \_\_\_\_\_ Ft. from W. Line

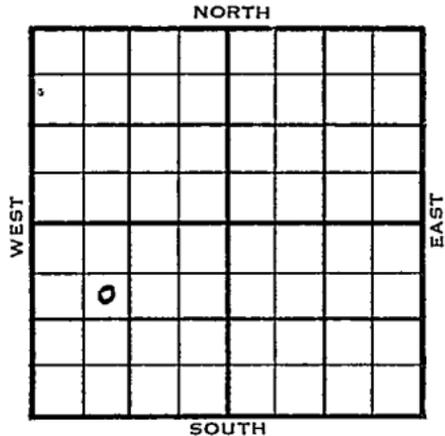

SE NW SW

	ELEVATION	REPORT
1954	1878'	

6/30

Location

7/7

10" @ 300'  
Drlg. 2700'

7/28

Spud 6-30-54 D & A TD 3368  
 10" @ 300 Heeb 3002 Dodge 3021  
 Lans. 3058 Gorham 3336  
 DST 3332-36 open 1/2 hr rec 4' mud  
 790# DST 3336-38 open 1 hr rec  
 450' oil, 540' OCM, 900' wtr.  
 890# TD 3368' 5" @ 3368  
 CO to 3350 30/3336-39 dry.  
 500 A S/SO PB 2980 36/3856-69  
 500 A PB 2485 36/2459-63 dry  
 D & A

**ABANDONED**

O.W.W.O.

1954  
8/4

Line 3058', Gorham 3336'  
 OTD 3368'  
 5" @ 3368'  
 CO to 3368'  
 To perf.

**OVER**

County Russell State Kansas

Sec. 5 (Blk.) 14 (Sur.) 14W Map No.

Operator Icer Addis

Well No. 4 Farm Boxberger

Elev. 1878 Location SE NW SW


990Ft. From N Line SW

990Ft. From W Line Quarter

Ist. Report

Completion JUL 28 1954

**ABANDONED**

Remarks

Spudding Date 6-30-54

Drlg. Data D & A TD 3368

10" @ 300 Heeb. 3002 Dodge 3021

Lans. 3058 Gorham 3336 DST 3332-36

open 1/2 hr. Rec. 4' mud 790#

DST 3336-38 open 1 hr. Rec. 450' oil

540' ocm 900' wtr. 890# TD 3368

5" @ 3368 CO to 3350 30/ 3336-39

dry 500 A S/ SO PB 2980 36/ 2856-

69 500 A PB 2485 36/ 2459-63 dry

D & A



O.W.W.O.

County Russell State Kansas

Sec. 5 (Blk. Twp.) 14 (Sur. Rge.) 14W Map No.

Operator Icer Addis

Well No. 4 Farm Boxberger

Elev. Location SE NW SW


990 Ft. From N Line SW

990 Ft. From W Line Quarter

1st. Report AUG 4 1954

Completion O.W.W.O.

Remarks O.W.W.O.

Spudding Date

Drlg. Data Atherton Pool

Lime 3058 Gorham 3336 OTD 3368

5" @ 3368 CO to 3368 to perf.



1954  
8/18

Oil Well

TD 3368'

Lime 3058', Gorham 3336'

OTD 3368'

5" @ 3368'

CO to 3368'

8/3336-38,

B/oil & wtr.

FU 800' oil & wtr. 12 hrs.

200' was oil

P/25 bopd

Comp. 20 bopd 80 bw

**COMPLETED**