


DX 78-1

Section ~~6~~ 5 Township 14 Range 14W
Well No. 2 H. Boxberger
Company 2 Mast Drlg.

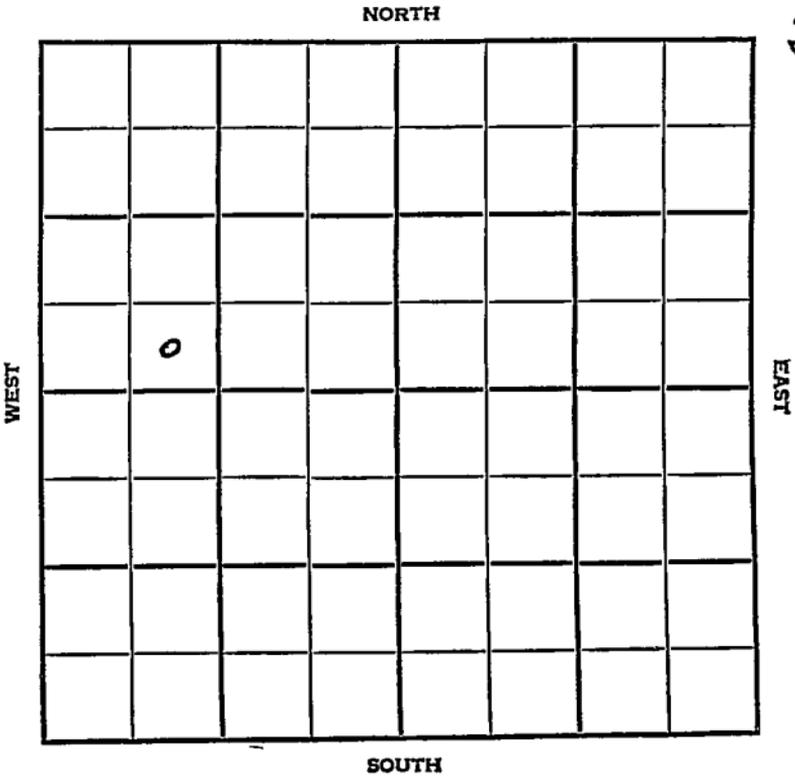

County **Russell** State **Kansas**

Sec. **6** (Blk.) **14** (Sur.) **14W** Map No.

Operator **Mast Drlg.**

Well No. **2** Farm **H. Boxberger**

Elev. Location **SE SW NW**

330 Ft. From **S** Line **NW**

990 Ft. From **W** Line Quarter

Ist. Report **JUN 9 1954**

Completion

Remarks

Mast Drlg. - Contr.

Spudding Date **6-3-54**

Drlg. Data **Gorham Pool**

8" @ 235 drlg. 2090

Kansas

Map No. _____ Sec. 5 Twp. 14 R. 14W

Well No. 2 H. Boxberger

Mast Drlg. _____ Company _____

CORRECTION, Contractor _____

SE SW NW

SECTION PLAT

_____ Ft. from N. Line

330 Ft. from S. Line

_____ Ft. from E. Line

990 Ft. from W. Line

Russell County

Location _____

Rig up _____

Drilling and Remarks: _____

Reported

6-14-14^W

RECORD

Cased _____ in., _____ ft.

Sand _____

Gas _____

Oil _____

Total Depth _____

PRODUCTION

1st 24 hrs. Nat. _____

1st 24 hrs. after shot _____

Gas _____ Cu. Ft.

Dry Hole _____

Abandoned _____

Date

JUN 15 1954

19

J. G. McGEHEE

Scout

