

KANSAS


Russell

FORM 51 5M 1-42 PETROL

Section 5 Township 14 Range 14-W

Well No #1 H. Boxberger

Company Hartman & Blair

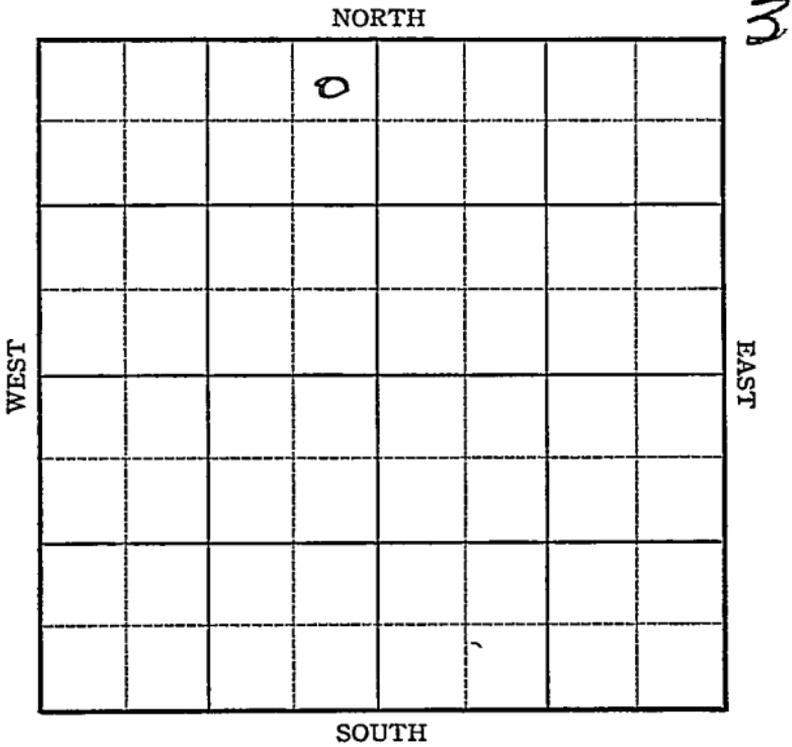


Sec. 5 Twp. 14 R. 14-W

Well No. #1 H. Boxberger Farm

Hartman & Blair Company

NORTH

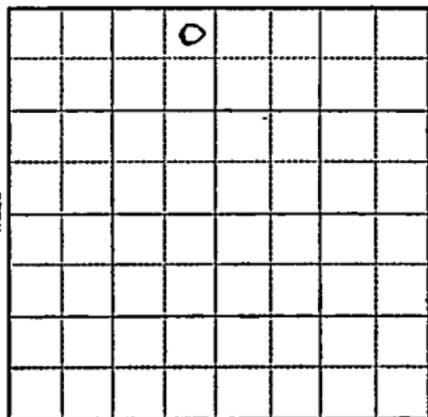

330 Ft. from N. Line

_____ Ft. from S. Line

330 Ft. from E. Line

_____ Ft. from W. Line

Elev. 1844

SOUTH

1943

R E P O R T

11/24 Location.

12/1 "

12/8 8" @ 131

12-15 Drlg. 800'

Drlg. 2700'

12/22 Lans 2924

Arb 3295

TD 3330 fo dun Schl.

12-29 TD 3330'

Topeka 2745'

Lans 3029'

Arb. 3300'

No shows

COMPLETED

KANSAS

Map No. 72 Sec. 5 Twp. 14 R. 14W

Well No. 1 H. Boxberger

Hartman & Blair Company

FIRST REPORT Contractor

NE NW


SECTION PLAT

330 Ft. from N. Line

_____ Ft. from S. Line

330 Ft. from E. Line

_____ Ft. from W. Line

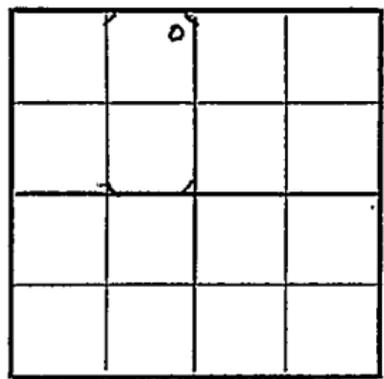

Witt Pool

Location X

Rig up _____

Drilling and Remarks:

RECORD

Cased _____ in., _____ ft.

Sand _____

Gas _____

Oil _____

Total Depth _____

PRODUCTION

1st 24 hrs. Nat. _____

1st 24 hrs. after shot _____

Gas _____ Cu. Ft.

Dry Hole _____

Abandoned _____

Date

NOV 24 1943 19

S. J. LEWIS Scout

KANSAS

Map No. 72 Sec. 5 Twp. 14 R. 14WWell No. 1 H. BoxbergerHartman & Blair Company~~COMPLETED~~ Contractor

NE NW

330 Ft. from N. Line

Ft. from S. Line

330 Ft. from E. Line

Ft. from W. Line

SECTION PLAT

		0	

Witt Pool

Location _____

Rig up _____

Drilling and Remarks:

*Topeka 2745**Kans 3029**City 8300**No shows*

RECORD

Cased _____ in., _____ ft.

Sand _____

Gas _____

Oil _____

Total Depth 3330

PRODUCTION

1st 24 hrs. Nat. _____

1st 24 hrs. after shot _____

Gas _____ Cu. Ft.

Dry Hole _____

Abandoned 3330

Date

DEC 29 1943 19 _____

S. J. LEWIS Scout