


Section 5 Township 14 Range 11W

Well No. #1 L. Boxberger


Company Icer Addis et al

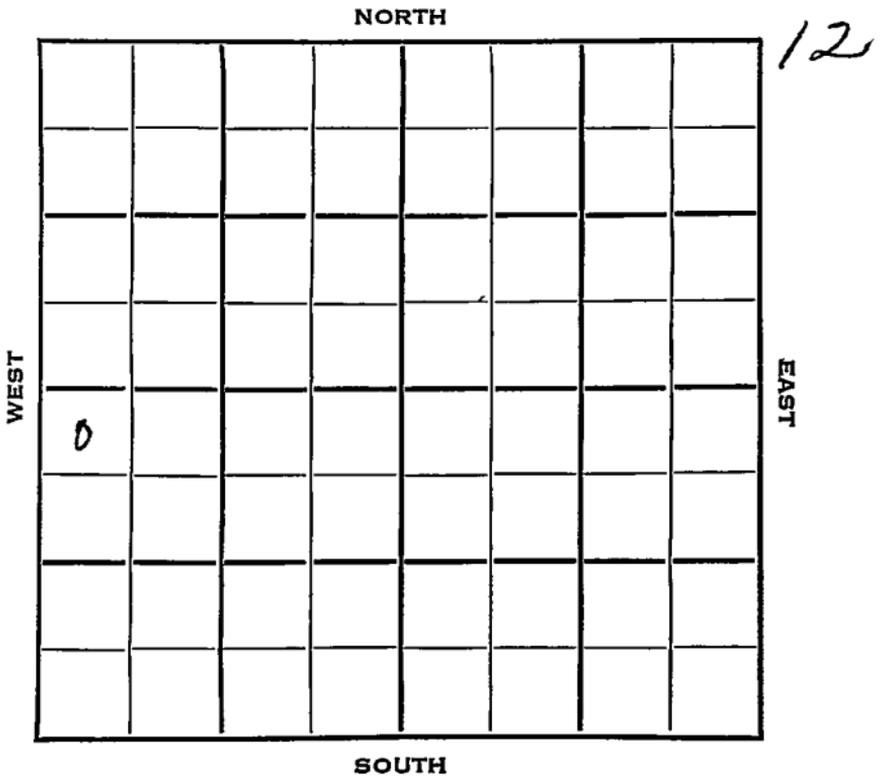

Russell KANSAS

SEC.	TWP.	R.
5	14	14 W ✓
WELL NO.		
#-1 L. Boxberger		FARM
COMPANY		
Ficer Addis et al		
CONTRACTOR		
Mast Drlg.		

330 \_\_\_\_\_ Ft. from N. Line  
 \_\_\_\_\_ Ft. from S. Line  
 \_\_\_\_\_ Ft. from E. Line  
 330 \_\_\_\_\_ Ft. from W. Line

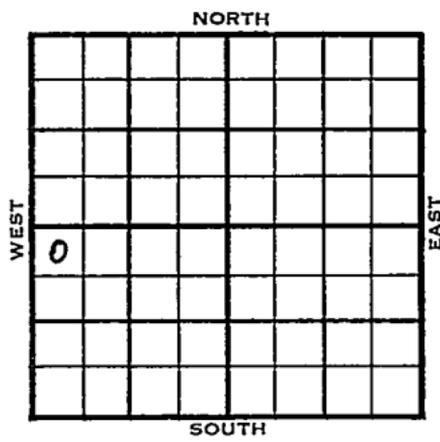

NW NW SW

	ELEVATION	REPORT
1954	1873'	
3/17	Spud 3-14-54 Drlg. 674'	
4/7	Spud 3-14-54 Oil Well TD 3325' 8" @ 908' Grandhaven 2440', 1st Tarkio 2456', Top 2771' DST 3028', opn 1 hr., rec. 10' mud, 30# Lans 3048' DST 3050-95', opn 1 hr., rec. 10' mud, Gorham 3322' TD 3325' 5" @ 3325' CO to 3325', FU 2500' oil Comp. 25 bopd	

**COMPLETED**

County **Russell** State **Kansas**

Sec. **5** (Blk.) **14** (Sur. Rge.) **14W** Map No.

Operator **Icer Addis. etal.**

Well No. **1** Farm **L. Boxberger**

Elev. Location **NW NW SW**


**330** Ft. From **N** Line **SW**

**330** Ft. From **W** Line Quarter

Ist. Report **MAR 17 1954**

Completion

Remarks

**Mast Drlg. - Contr.**

Spudding Date **3-14-54**

Drlg. Data

**drlg. 674**

County Russell State Kansas

Sec. 5 (Blk. 14) (Sur. 14W) (Twp.) (Rge.) Map No.

Operator Icer Addis etal.

Well No. 1 Farm L. Boxberger

Elev. 1873 Location NW NW SW


330 Ft. From N Line SW

330 Ft. From W Line Quarter

Ist. Report

Completion APR 7 1954

Remarks

Mast Drlg. - Contr.

Spudding Date 3-14-54

Drlg. Data Oil well TD 3325

8" @ 908 Grandhaven 2440 1st Tarkio 2456

Top. 2771 DST 3028 open 1 hr. Rec.

10' mud 30# Lans. 3048 DST 3050-95

open 1 hr. Rec. 10' mud Gorham 3322

TD 3325 5" @ 3325 CO to 3325

FU 2500' oil Comp. 25 bopd