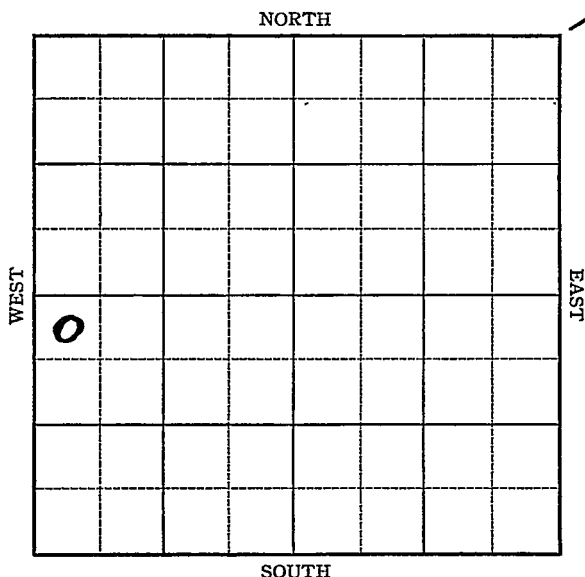


Russell

Section 6 Township 14 Range 14 - WWell No. 2 - AmeliaCompany Phillips


Sec. 6 Twp. 14 R. 14-WWell No. #2 Amelia FarmPhillips Company330 Ft. from N. Line

Ft. from S. Line

Ft. from E. Line

330 Ft. from W. Line

Elev. 1880

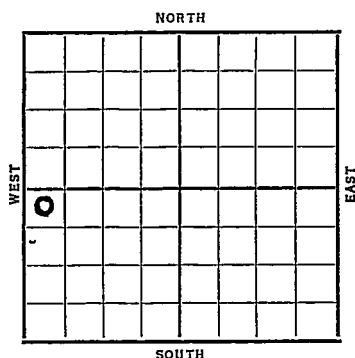

Date	REPORT
1937	
9/8	B.R.R.
9/17	R. U. R.
9/24	Cable. 15" @ 300'. Drlg. 390'
10/2	13" @ 439'. Any 915'.
	10" @ 925'. WOC.
10/8	Drlg. 1595'.
10/15	Drlg. 2400'.
10/22	8" @ 2499'. Tarkio 2546'.
	S.O. 2540'. T.D. 2584'.
	1500' fluid.
10/29	8" @ 2575'. WOC.
11/5	Tarkio 2579-85' T.D. 1100' oil.
	3000 acid.
11/12	" "
11/19	" "
11/26	" "
12/3	T.D. 2601'. Swab 175 bbls. oil
	in 5 hrs. SD repairs.
12/10	Pump 517 bbls. oil 13 hrs. with
	S.W.
	OVER

1937

12/17 T.D. 2601'.
S. D. O.

12/24 Testing.

12/31 T.D. 2744'. C.O.

1938

1/7 7" @ 2747'. Topeka 2768'.
T.D. 2771'. 2200' oil 20 Min.
Swab 708 bbls. oil in 8 hrs.
No water.

1/14 Testing.

1/19 7" @ 2747'.
Topeka 2768'.
T.D. 2771'.
Potential 1711 bbls.

COMPLETED

Russell KANSAS

Map No. _____ Sec. 6 Twp. 14 R. 14Well No. 2 - AmeliaPhillips Company

Contractor _____

FIRST REPORT

SECTION PLAT

330 Ft. from N. Line

_____ Ft. from S. Line

_____ Ft. from E. Line

330 Ft. from W. Line

0			

Location _____

Rig up _____

Drilling and Remarks:

BRR

RECORD

Cased _____ in., _____ ft.

Sand _____

Gas _____

Oil _____

Total Depth _____

PRODUCTION

1st 24 hrs. Nat. _____

1st 24 hrs. after shot _____

Gas _____ Cu. Ft.

Dry Hole _____

Abandoned _____

Date

SEP 8 1937 19

H. D. Hatfield

Scout

Russell KANSASMap No. 72 Sec. 6 Twp. 14 R. 14WWell No. 2 AmeliaPhillips

Company

Contractor

COMPLETED

NW SW

330 Ft. from N. Line

_____ Ft. from S. Line

_____ Ft. from E. Line

330 Ft. from W. Line**SECTION PLAT**

0			

Location _____

Rig up _____

Drilling and Remarks:

POT 1711**RECORD**Cased 7 in., 2747 ft.~~Sand~~ Topeka 2768

Gas _____

Oil _____

Total Depth 2771**PRODUCTION**

1st 24 hrs. Nat. _____

1st 24 hrs. after shot _____

Gas _____ Cu. Ft.

Dry Hole _____

Abandoned _____

Date

JAN 19 1938 19 H. D. Hatfield Scout