


Russell

KANSAS

Section 6 Township 14 Range 14-W

Well No. 1 Boxberger


Company Wakefield et al

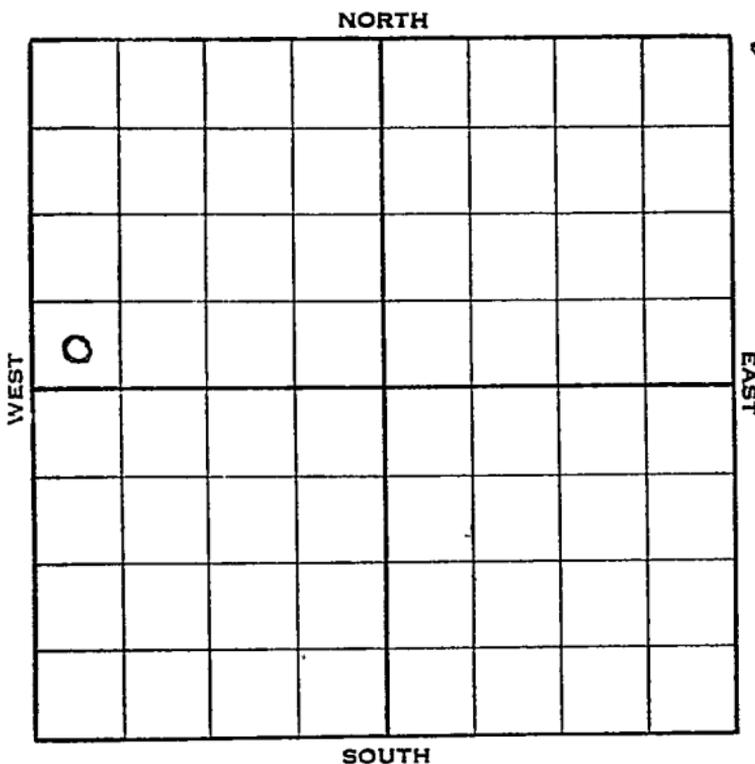

Sec. 6 Twp. 14 R. 14 ~~W~~

Well No. #1 Boxberger Farm  
Wakefield et al Company

\_\_\_\_\_ Ft. from N. Line  
330 Ft. from S. Line  
 \_\_\_\_\_ Ft. from E. Line  
330 Ft. from W. Line  
 Elev. 1880

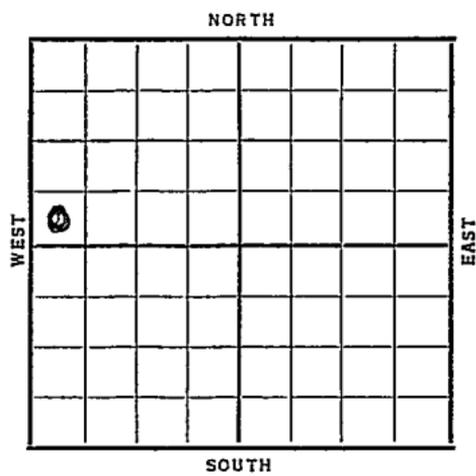

Date	REPORT
1938	
2/9	Location
2/18	"
2/26	RUCT.
3/4	Drlg. 410'.
3/11	12" @ 425'. Anhy 906'.
	10" @ 912'. Drlg. 1110'.
3/18	Drlg. 2020'.
3/25	8" @ 2520'. Drlg. 2750'.
4/1	S.O. 2931-37'. S.W. 3030'.
	K.C. 3057' T.D. 3100' gsg.
4/8	" " " " "
4/13	Arb. 3320'.
	T.D. 3329'. H.F.W.
	ABANDONED <del>COMPLETED</del> ABANDONED

Map No. \_\_\_\_\_ Sec. 6 Twp. 14 R. 14WWell No. 1 BoxbergerWakefield etal Company

Contractor

**FIRST REPORT**

SW NW

**SECTION PLAT**

\_\_\_\_\_ Ft. from N. Line

330 Ft. from S. Line

\_\_\_\_\_ Ft. from E. Line

330 Ft. from W. Line

0			

Location X

Rig up \_\_\_\_\_

Drilling and Remarks:

**RECORD**

Cased \_\_\_\_\_ in., \_\_\_\_\_ ft.

Sand \_\_\_\_\_

Gas \_\_\_\_\_

Oil \_\_\_\_\_

Total Depth \_\_\_\_\_

**PRODUCTION**

1st 24 hrs. Nat. \_\_\_\_\_

1st 24 hrs. after shot \_\_\_\_\_

Gas \_\_\_\_\_ Cu. Ft.

Dry Hole \_\_\_\_\_

Abandoned \_\_\_\_\_

Date

FEB 9 1938 19 H. D. Hatfield Scout

Russell KANSAS

Map No. 72 Sec. 6 Twp. 14 R. 14W

Well No. 1 Boxberger

Wakefield etal Company

Contractor

ABANDONED

SW NW

       Ft. from N. Line

330 Ft. from S. Line

       Ft. from E. Line

330 Ft. from W. Line

SECTION PLAT

0			

Location \_\_\_\_\_

Rig up \_\_\_\_\_

Drilling and Remarks:

*AFW*

*DVA*

RECORD

Cased \_\_\_\_\_ in., \_\_\_\_\_ ft.

Sand *Arb 3320*

Gas \_\_\_\_\_

Oil \_\_\_\_\_

Total Depth *3329*

PRODUCTION

1st 24 hrs. Nat. \_\_\_\_\_

1st 24 hrs. after shot \_\_\_\_\_

Gas \_\_\_\_\_ Cu. Ft.

Dry Hole \_\_\_\_\_

Abandoned \_\_\_\_\_

Date

APR '13 1938

H. D. Hatfield Scout