


FORM 51 IOM 12-46 PETROL

KANSAS

Section 6 Township 14 Range 14-W

Well No. #1 Boxberger

Company M. Armer
Hall-Gurney

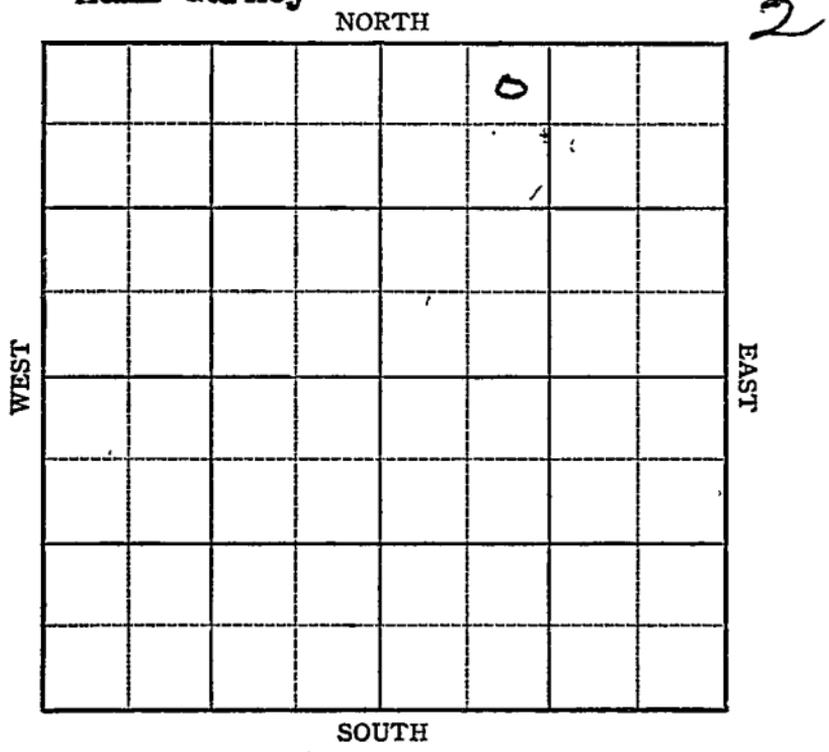

KANSAS

Russell

Sec. 6 Twp. 14 R. 14-W

Well No. #1 Boxberger Farm

M. Armer Company

Hall-Gurney


330 Ft. from N. Line

_____ Ft. from S. Line

_____ Ft. from E. Line

330 990 Ft. from W. Line

~~NE NE~~ NE NW NE

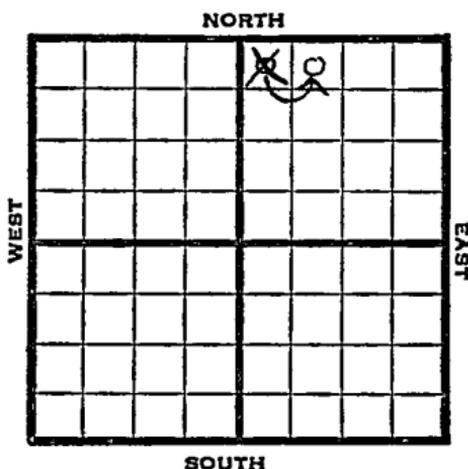

1947 Elev. 1859' REPORT

6/18 10" @ 128'
WOC

6/24 Drlg 2210'

7/1 Lansing 3030'
Drlg 3250'

7/8 " "

7-16 BKC 8260
Gorham 3308
TD 3312
5" @ 3309
RUST

7/22 "

7/29 TD 3312'

8/6 "

8/13 "

8/20 "

8/27 "

9/3 "

9/10 "

OVER

Map No. 72 Sec. 6 Twp. 14 R. 14W

Well No. 1 Boxberger

M. Armer Company

CORRECTION

Contractor

NE NW NE

SECTION PLAT

330 Ft. from N. Line

_____ Ft. from S. Line

_____ Ft. from E. Line

990 Ft. from W. Line

		o	

Russell County

Location _____

Rig up _____

Drilling and Remarks:

Reported

NW NE

RECORD

Cased _____ in., _____ ft.

Sand _____

Gas _____

Oil _____

Total Depth _____

PRODUCTION

1st 24 hrs. Nat. _____

1st 24 hrs. after shot _____

Gas _____ Cu. Ft.

Dry Hole _____

Abandoned _____

Date

JUN 25 1947 19

S. J. LEWIS Scout



Map No. _____ Sec. 6 Twp. 4 R. 14W

Well No. 1 Boxberger

M. Armer Company

FIRST REPORT

Contractor

NW NE


SECTION PLAT

330 Ft. from N. Line

_____ Ft. from S. Line

_____ Ft. from E. Line

330 Ft. from W. Line

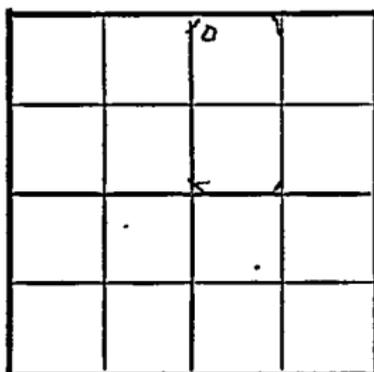

Russell County

Location _____

Rig up _____

Drilling and Remarks:

10" @ 128 WOC

RECORD

Cased _____ in., _____ ft.

Sand _____

Gas _____

Oil _____

Total Depth _____

PRODUCTION

1st 24 hrs. Nat. _____

1st 24 hrs. after shot _____

Gas _____ Cu. Ft.

Dry Hole _____

Abandoned _____

Date

JUN 1 8 1947 19

S. J. LEWIS Scout

Form 26 200 Bks. 10-46 Petrol
Kansas

Map No. 72 Sec. 6 Twp. 14 R. 14W

Well No. 1 Boxberger

M. Armer Company

COMPLETE

Contractor

NE NW NE

E. 1868

SECTION PLAT

330 Ft. from N. Line

_____ Ft. from S. Line

_____ Ft. from E. Line

990 Ft. from W. Line

		0	

Russell County

Location _____

Rig up _____

Drilling and Remarks:

Topka 2760
Lanning 3030
Yorkham 3305
5" C3309
Pump 25 oil + 20 70W
St.
40 2/3

RECORD

Cased _____ in., _____ ft.

Sand _____

Gas _____

Oil _____

Total Depth 3312

PRODUCTION

1st 24 hrs. Nat. _____

1st 24 hrs. after shot _____

Gas _____ Cu. Ft.

Dry Hole _____

Abandoned _____

Date

NOV 12 1947 19

S. J. LEWIS

Scout

1947

9/17 TD 3312'

9/24 "

10/1 "

10/8 Pump 15 bbls oil PH.

10/15 " " " " " "

10/22 " " " "

10/29 " " " "

11/5 " " " "

11/12 Topeka 2760'

Lansing 3030'

Gorham 3308'

5" @ 3309'

Pump 25 oil & 20% W Pot.

40° Gr.

Total Depth 3312'

COMPLETED