

Barton


KANSAS

Form 51-5M 5-37 Petrol

Section 18 Township 16 Range 13-W

Well No. #1 Luerman

Company Shell

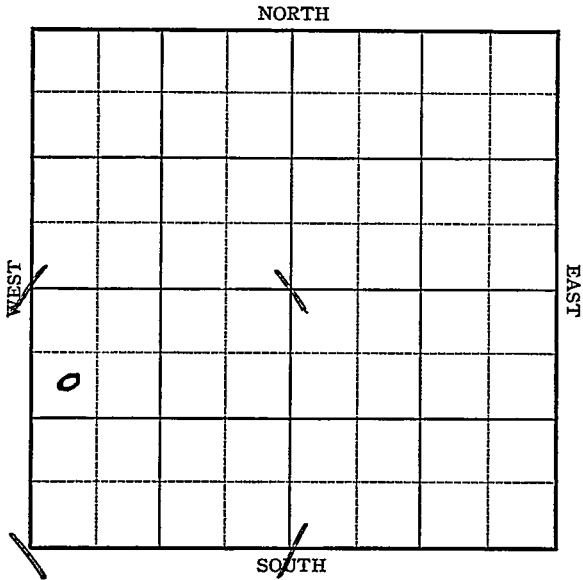


KANSAS

Barton

Sec. 18 Twp. 16 R. 13-WWell No. #1 Luerman FarmShell Company990 Ft. from N. Line Ft. from S. Line Ft. from E. Line330 Ft. from W. Line

Elev. 1928

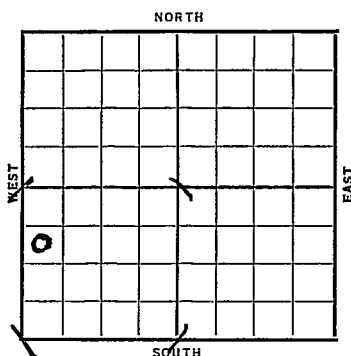

Date	REPORT
1937	
10/27	R. R.
11/5	10" @ 647'. WOC.
11/12	Drl g. 2235'.
11/19	K.C. 3129'. Drl g. 3277'.
11/26	Sil. 3352'. T.D. 3356'.
	7" @ 3354'. RUST. S.O.
12/3	T.D. 3374'. 1400' oil.
	Swab 94 bbls. oil in 6 hrs.
	4000 acid. Pump 449 bbls. oil & 22 bbls. water in 4 hrs.
	Shut down.
12/8	7" @ 3354'.
	Sil. 3352'.
	T.D. 3374'.
	4000 acid.
	Pot. 2678 bbls.
	COMPLETED

Barton KANSAS

Map No. _____ Sec. 18 Twp. 16 R. 13WWell No. 1 Luerman

Shell

Company

Contractor

FIRST REPORT

SW NW SW


990 Ft. from N. Line

_____ Ft. from S. Line

_____ Ft. from E. Line

330 Ft. from W. Line

SECTION PLAT

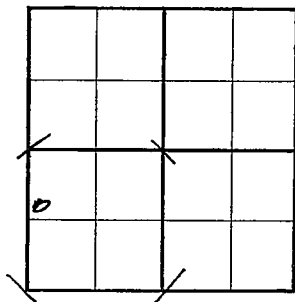

Location _____

Rig up _____

Drilling and Remarks:

RR

RECORD

Cased _____ in., _____ ft.

Sand _____

Gas _____

Oil _____

Total Depth _____

PRODUCTION

1st 24 hrs. Nat. _____

1st 24 hrs. after shot _____

Gas _____ Cu. Ft.

Dry Hole _____

Abandoned _____

Date

OCT 27 1937

H. D. Hatfield

Scout

Barton KANSAS

Map No. _____ Sec. 18 Twp. 16 R. 13WWell No. 1 LuermanShell Company

Contractor

COMPLETED990 SW NW SW
Ft. from N. Line

_____ Ft. from S. Line

_____ Ft. from E. Line

330 Ft. from W. Line**SECTION PLAT**

0			

Location _____

Rig up _____

Drilling and Remarks:

*4000 acid**POT-2678***RECORD**Cased 7 in., 3354 ft.Sand sil 3352

Gas _____

Oil _____

Total Depth 3374**PRODUCTION**

1st 24 hrs. Nat. _____

1st 24 hrs. after shot _____

Gas _____ Cu. Ft.

Dry Hole _____

Abandoned _____

Date

DEC 8 - 1937 19 H. D. Hatfield Scout