

Russell

DX 78-1

KANSAS

Section 5 Township 14 Range 11W

Well No. #2 L. Boxberger

Company Addis-Boxberger

NORTH

12

WEST

EAST

	0						

SOUTH


Russell KANSAS

SEC.	TWP.	R.
5	14	14W ✓

WELL NO. 2 E. Boxberger FARM
 COMPANY Addis-Boxberger

CONTRACTOR Mast Drlg.
 Gorham Pool

330 Ft. from N. Line
 Ft. from S. Line
 Ft. from E. Line
 990 Ft. from W. Line

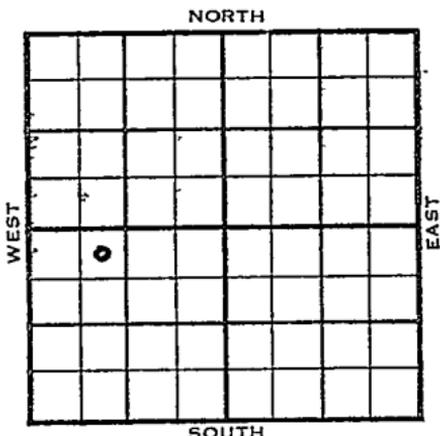

NE NW SW

1954	ELEVATION 1875'	REPORT
------	-----------------	--------

4/27 Spud 4-25-54
 Drlg.
 5/5 8" @ 914 w/425 Anhy 900'
 Tarkio 2457' Heeb 2996 Lans 3050
 Drlg. 3058'
 5/12 Gorham 3322 RTD 3323 5" @ 3322
 CO 3323' S/25 BOPD
 5/19 Spud 4-25-54 Oil well TD 3323
 8" @ 914 Anhy 900 Tarkio 2457
 Heeb 2996 Lans 3050 Gorham 3322
 TD 3323 5" @ 3322 CO to 3323
 S/25 BOPH S/20 BOPH 16 hr.
 Comp. 25 BOPD

COMPLETED

County **Russell** State **Kansas**

Sec. **5** (Blk.) **14** (Sur.) **14W** Map No.

Operator **Addis-Boxberger**

Well No. **2** Farm **L. Boxberger**

Elev. Location **NE NW SW**

FIRST REPORT					
0					

330 Ft. From **N** Line **SW**

990 Ft. From **W** Line **Quarter**

Ist. Report **APR 27 1954**

Completion

Remarks

Mast Drlg. - Contr.

Spudding Date **4-25-54**

Drlg. Data **Gorham Pool**

drlg.

County Russell State Kansas

Sec. 5 (Blk. 14) (Sur. 14W) Map No.

Operator Addis-Boxberger

Well No. 2 Farm L. Boxberger

Elev. 1875 Location NE NW SW

330 Ft. From N Line SW

990 Ft. From W Line Quarter

1st. Report

Completion MAY 1 9 1954

Remarks Gorham Pool

Mast Drlg. - Contr.

Spudding Date 4-25-54

Drlg. Data Oil well TD 3323

8" @ 914 Anhy 900 Tarkio 2457

Heeb. 2996 Lans. 3050 Gorham 3322

TD 3323 5" @ 3322 CO to 3323

S/ 25 boph S/ 20 boph 16 hr.

Comp. 25 bopd