

FORM **C.W.W.O.**


Russell

KANSAS

Section 5 Township 14 Range 14 W

Well No: # 3 L. Boxberger

Company ~~Addis & Boxberger~~  
Icee Addis

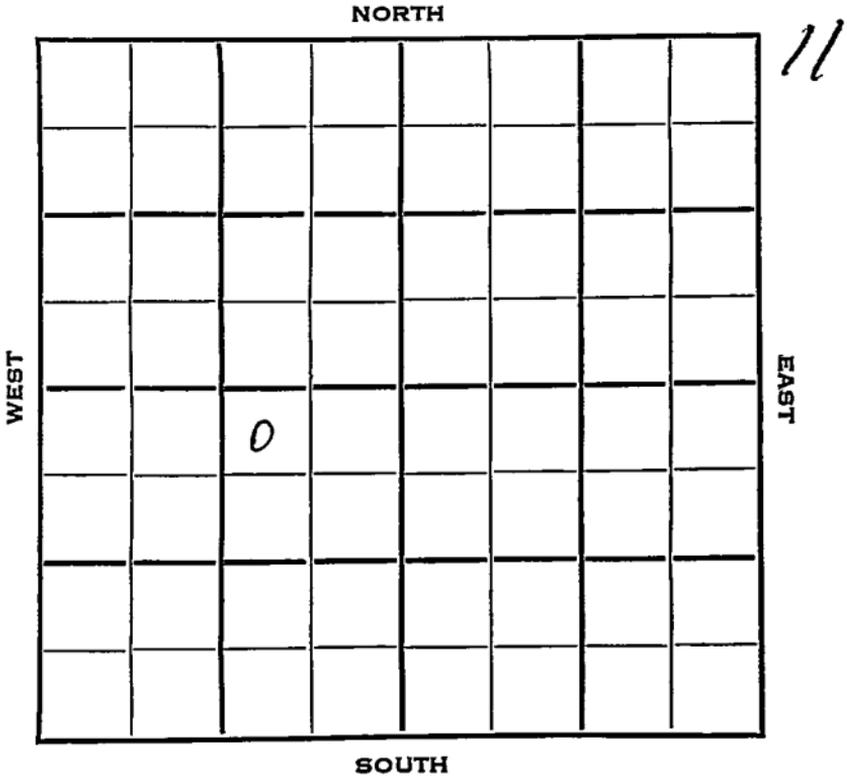

O.W.W.O.

Russell KANSAS

SEC.	TWP.	R.
5	14	14W ✓

WELL NO. 3 L. Boxberger FARM

COMPANY *Icen Addis*  
~~Addis & Boxberger~~


CONTRACTOR Mast Drlg.  
Atherton Pool

330 Ft. from N. Line

Ft. from S. Line

990 Ft. from E. Line

Ft. from W. Line

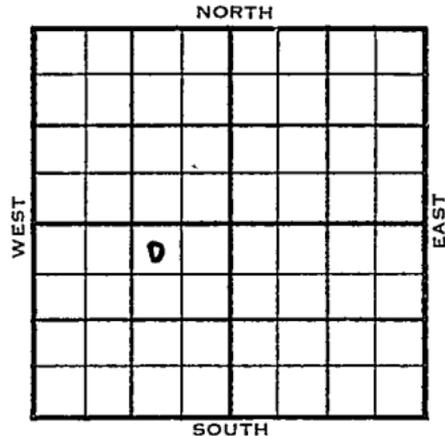

NW NE SW

1954	ELEVATION 1872'	REPORT
------	-----------------	--------

5/12 Spud 5-8-54  
Anhy 897'  
8" @ 907'  
Drlg. 940'

5/19 Drlg. 3280'

5/26 Spud 5-8-54  
D&A  
TD 3333'  
Anhy 897'  
8" @ 907'  
Tarkio 2454', Lans 3050', Gorham 3330'  
DST 3330-31', opn 1 hr., rec. 8' socm, 974#  
DST 3331-33', opn 1 hr., rec. 15' oil, 600' SW, 911#  
TD 3333'  
D&A

**ABANDONED**

**OVER**

1954  
7/21

### O.W.W.O.

Lans. 3050' Gorham 3330'  
OTD 3333' DD 3421' 5" @ 3357' WOC

8/18

SWD Well  
TD 3421'  
Lans 3050', Gorham 3330'  
OTD 3333'  
DD 3421'  
5" @ 3357'  
CO to 3421' 5000A  
Comp. SWD Well 400 bwph

ABANDONED







O.W.W.O.

County Russell State Kansas

Sec. 5 (Blk. Twp.) 14 (Sur. Rge.) 14W Map No.

Operator Icer Addis

Well No. 3 Farm Boxberger

Elev. Location NW NE SW

ABANDONED									

330 Ft. From N Line SW

990 Ft. From E Line Quarter

Ist. Report

Completion AUG 18 1954

O.W.W.O. OWWO

Mast Drig. - Contr.

Spudding Date

Drlg. Data SWD well TD 3421

Lans. 3050 Gorham 3330 OTD 3333

DD 3421 5" @ 3357 CO to 3421

5000 A Comp. SWD well 400 bwph

FABEN GILSTRAP