

KANSAS

Form 51-5M-7-40-Palace

Russell


Section 6 Township 14 Range 14-W

Well No. 3 Amelia

Company Phillips

NORTH Cumler Pool

12

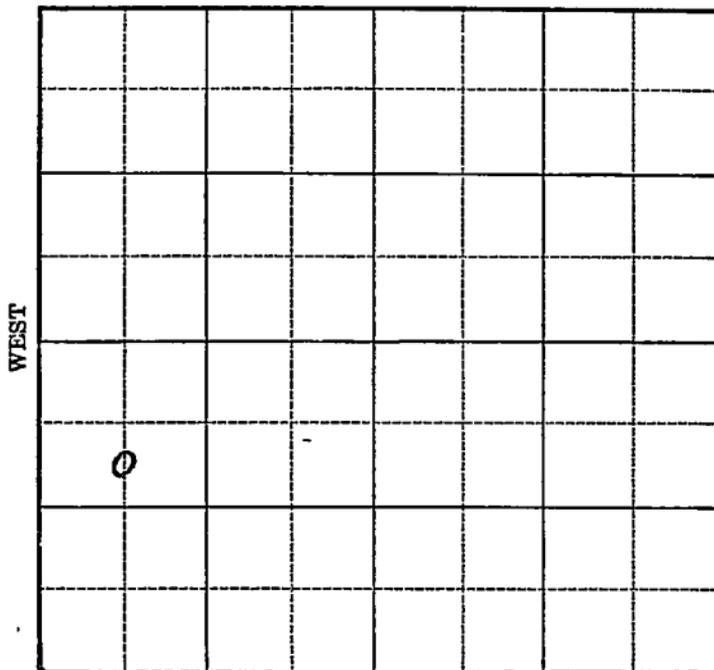

SOUTH

Sec. 6 Twp. 14 R. 14-W

Well No. #3 Amelia Farm _____

Phillips Company _____

(Dumler)


990 Ft. from N. Line

_____ Ft. from S. Line

_____ Ft. from E. Line

624 Ft. from W. Line

Elev. 1883

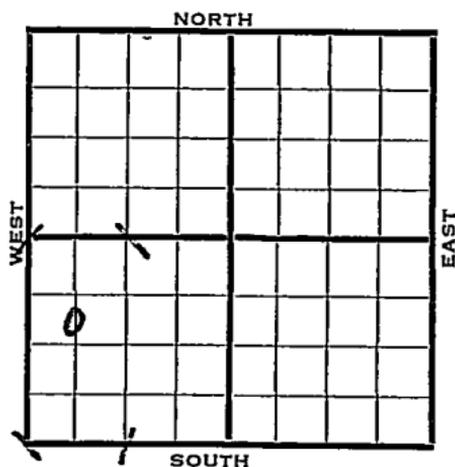

1941	REPORT
1/22	Location
1/30	Cable.
2/6	Shut down.
2/13	Spud 150'
2/20	850' crooked hole.
2/27	Anhy 911' 10" - 920' WOC.
3/6	Drlg. 1825'
3/13	2570' run 8".
3/20	8" - 2785' S.O. 2858-64' in
	Topeka. Drlg. 2935'
3/27	Topeka 2780' Lans. 3064'
	T.D. 3180' 7" - 3175' RUST.
4/2	T.D. 3298' U.R. 7".
4/10	Gorham 3324-26 1/2' T.D.
	7" - 3324' WOC.
4/18	" " "
4/24	Shut down.
	OVER

Map No. 72 Sec. 6 Twp. 14 R. 14WWell No. 3 AmeliaPhillips Company

Contractor

FIRST REPORT

C S L NW SW


990 Ft. from N. Line

_____ Ft. from S. Line

_____ Ft. from E. Line

624 Ft. from W. Line

DUMLEFR POOL

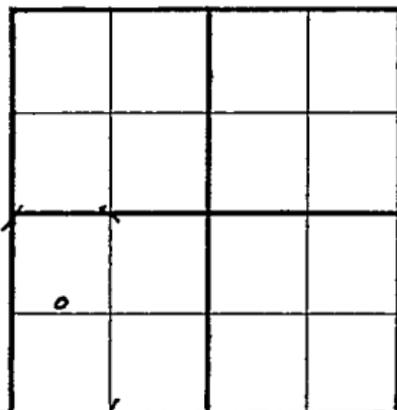SECTION PLATLocation X

Rig up _____

Drilling and Remarks:

RECORD

Cased _____ in., _____ ft.

Sand _____

Gas _____

Oil _____

Total Depth _____

PRODUCTION

1st 24 hrs. Nat. _____

1st 24 hrs. after shot _____

Gas _____ Cu. Ft.

Dry Hole _____

Abandoned _____

Date

JAN 22 1941 19

S. J. LEWIS Scout

Map No. _____ Sec. 6 Twp. 14 R. 14W

Well No. 3 Amelia

Phillips Company

ABANDONED Contractor

C S L NW SW

990 Ft. from N. Line

_____ Ft. from S. Line

_____ Ft. from E. Line

624 Ft. from W. Line

DUMLER POOL

SECTION PLAT

Location _____

Rig up _____

Drilling and Remarks:

See log 3324
7" @ 3324
Water.

RECORD

Cased _____ in., _____ ft.

Sand _____

Gas _____

Oil _____

Total Depth 3,338 1/2

PRODUCTION

1st 24 hrs. Nat. _____

1st 24 hrs. after shot _____

Gas _____ Cu. Ft.

Dry Hole _____

Abandoned _____

Date

APR 30 1941 19

S. J. LEWIS Scout

1941
4/30

Gorham 3324'
7" - 3324'
T.D. 3338½'
Water.

ABANDONED