


SECTION 6 TOWNSHIP 14 RANGE 14W

WELL NO. #1 Brown

COMPANY Frontier Oil

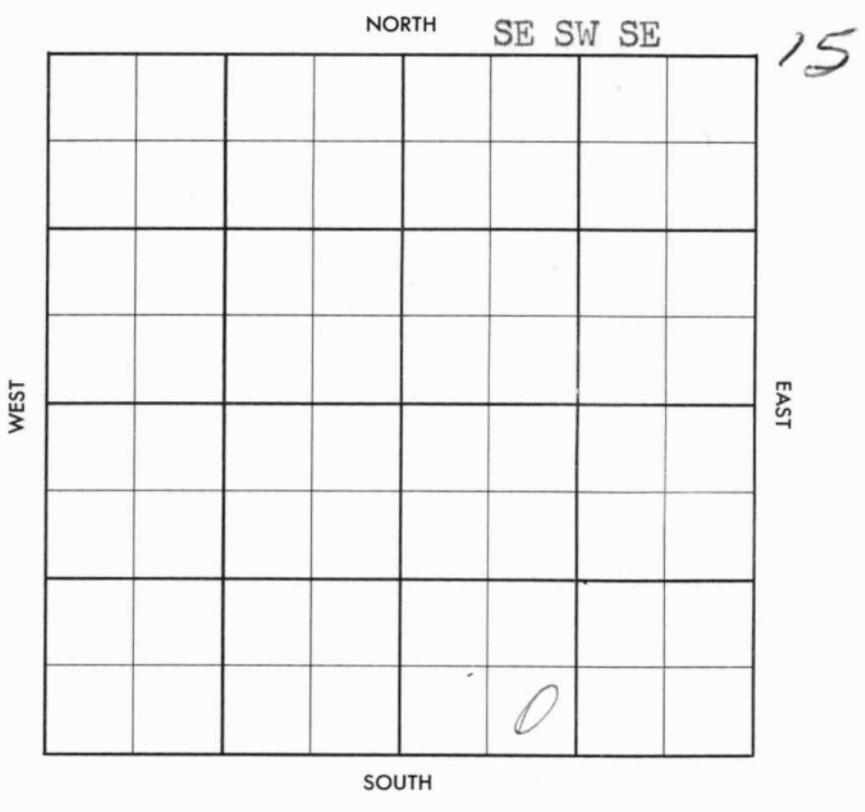

County Russell Elev. _____
 Sec. 6 Twp. 11/4 Rge. 11/W
 Company Frontier Oil
 Farm Name Brown No. 1

TOPS	DEPTH	LOG	DATUM	Loc. in Sec.
Anh.				SE SW SE
Tp.				
H.				
Tr.				
Dg.				
Bl.				
L.				Geol. _____
K.C.				Contr. _____
B.K.C.				<u>Red Tiger</u>
Ce.				Pool _____
C.				<u>Gorham</u>
M.				
M.				
K.				
Mz.				
Me.				
V.				
S.				
S.				
A.				
R.				
Pe.				
G.				
T.D.				

MAY 57
FIRST REPORT

Date Comm. _____

Location _____

[Handwritten scribbles and a large '3' with a diagonal line through it]

Co.

Co.

R.

County Russell Elevation 1883
 Sec. 6 Temp. 11 Rge. 14W
 Company Frontier Oil
 Farm Name Brown No. 1

TOPS	DEPTH	LOG	DATUM	Loc. in Sec.
Anb.	916			SE SW SE
T.P.				
H. <u>Tark sd</u>	2476			
Tr. <u>TD</u>	2795			
Dg. <u>HB</u>	3020			
Bl. <u>TR</u>	3040			
L.	3076			
K.C.				Geol.
B.K.C.				Contr.
Ce.				Red Tiger
C.				
M.				
M.				Pool
K.				Gorham
Mz.				
Ma.				
V.				
S.				
S.				
A				ABANDONED
R. <u>sd</u>	3336			
PE.				MAY 22 57
G.				
T.D.	3342			

Date Comm.

Location MAY 6 57 MIR MAY 15 57

5-6-57 8⁵/₈ 325/160
D 2085 MAY 22 57 DST 2469-2539
1hr. rec 155' MSW BHP 810
FP 0-160 DST 2937-3009
1hr. rec 70' MSW BHP 870
DST 3028-52 1hr. rec 80' 50
& GCM 470/20" DST 3056-85
40" rec 25' WM BHP 890 DST

3093-3121 GN 40" 200' G.P.
rec 1925' SW BHA 1150 FP
580-1140

DEA