

26-10-11E

STATE CORPORATION COMMISSION OF KANSAS
OIL & GAS CONSERVATION DIVISION
WELL COMPLETION OR RECOMPLETION FORM
ACO-1 WELL HISTORY
DESCRIPTION OF WELL AND LEASE

Operator: License # Unknown 7183
Name Roxy Resources
Address 1625 Broadway
City/State/Zip Denver, CO 80202

Purchaser N/A

Operator Contact Person Charles A. Paulson
Phone (316) 269-7600

Contractor: License # 5840
Name Brandt Drilling

Wellsite Geologist N/A
Phone

Designate Type of Completion

☒ New Well ☐ Re-Entry ☐ Workover

☐ Oil ☐ SWD ☐ Temp Abd
☐ Gas ☐ Inj ☐ Delayed Comp.

If (SWD): old well info as follows:

Operator
Well Name
Comp. Date Old Total Depth

WELL HISTORY

Drilling Method:

☒ Mud Rotary ☐ Air Rotary ☐ Cable

12-15-82 12-23-82 12-23-82
Spud Date Date Reached TD Completion Date

3290' 0
Total Depth PBD

Amount of Surface Pipe Set and Cemented at N/A feet
Multiple Stage Cementing Collar Used? ☐ Yes ☒ No
If yes, show depth set feet
If alternate 2 completion, cement circulated
from feet depth to w/ SX cmt
Cement Company Name
Invoice #

API NO. 15-..... 197-20,140

County Wabaunsee

C SW Sec. 26 Twp. 10 Rge. 11 ☒ East
..... West

760
4620
Ft North from Southeast Corner of Section
Ft West from Southeast Corner of Section
(Note: Locate well in section plat below)


Lease Name Arand Well #. 1-26

Field Name Wildcat

Producing Formation Simpson (Target)

Elevation: Ground 1100' B. N/A

Section Plat

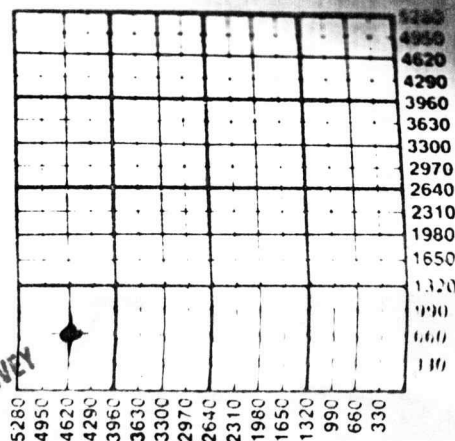

MAY 28 1986
KANSAS GEOLOGICAL SURVEY
WICHITA BRANCH

WATER SUPPLY INFORMATION

Disposition of Produced Water: ☐ Disposal
Docket # ☐ Repressuring

Questions on this portion of the ACO-1 call:

Water Resources Board (913) 296-3717

Source of Water:

Division of Water Resources Permit #.....

Groundwater Ft North from Southeast Corner
(Well) Ft West from Southeast Corner of
Sec Twp Rge East West

Surface Water Ft North from Southeast Corner
(Stream, pond etc) Ft West from Southeast Corner
Sec Twp Rge East West

Other (explain)
(purchased from city, R.W.D. #)

INSTRUCTIONS: This form shall be completed in duplicate and filed with the Kansas Corporation Commission, 200 Colorado Derby Building, Wichita, Kansas 67202, within 90 days after completion or recompletion of any well. Rule 82-3-130 and 82-3-107 apply.

Information on side two of this form will be held confidential for a period of 12 months if requested in writing and submitted with the form. See rule 82-3-107 for confidentiality in excess of 12 months.

One copy of all wireline logs and drillers time log shall be attached with this form. Submit CP-4 form with all plugged wells. Submit CP-111 form with all temporarily abandoned wells.

All requirements of the statutes, rules and regulations promulgated to regulate the oil and gas industry have been fully complied with and the statements herein are complete and correct to the best of my knowledge.

Signature Charles A. Paulson
Charles A. Paulson

Title..... Area Production Engineer Date 5-23-86
TXO Production Corp.
155 N. Market, #1000, Wichita, KS. 67202

Subscribed and sworn to before me this 23rd day of May 1986

Notary Public..... Connie F. Koehler

Date Commission Expires..... July 10, 1988

Connie F. Koehler
NOTARY PUBLIC
State of Kansas
7/10/88

K.C.C. OFFICE USE ONLY

F ☐ Letter of Confidentiality Attached
C ☐ Wireline Log Received
C ☐ Drillers Timelog Received
Distribution
☒ KCC ☐ SWD/Rap ☐ NGPA
☒ KGS ☐ Plug ☐ Other
(Specify)

Form ACO-1 (7-84)

Sec 211.11 (1)

KANSAS GEOLOGICAL SURVEY
WICHITA DIVISION
MAY 27 1986

26-10-11E

Operator Name Roxy Resources Lease Name Arand Well # 1-26
 Sec. 26 Twp. 10S Rge. 11 ☒ East ☐ West County Wabaunsee

WELL LOG

INSTRUCTIONS: Show important tops and base of formations penetrated. Detail all cores. Report all drill stem tests giving interval tested, time tool open and closed, flowing and shut-in pressures, whether shut-in pressure reached static level, hydrostatic pressures, bottom hole temperature, fluid recovery, and flow rates if gas to surface during test. Attach extra sheet if more space is needed. Attach copy of log.

Drill Stem Tests Taken ☐ Yes ☐ No
 Samples Sent to Geological Survey ☐ Yes ☐ No
 Cores Taken ☐ Yes ☐ No

Formation Description
☐ Log ☐ Sample

Name Top Bottom

N/A

MAY 28 1986
 KANSAS GEOLOGICAL SURVEY
 WICHITA BRANCH

CASING RECORD ☐ New ☐ Used

Report all strings set-conductor, surface, intermediate, production, etc.

Purpose of String	Size Hole Drilled	Size Casing Set (in O.D.)	Weight Lbs/Ft.	Setting Depth	Type of Cement	#Sacks Used	Type and Percent Additives
.....							
.....							
.....							

PERFORATION RECORD

Shots Per Foot	Specify Footage of Each Interval Perforated	Acid, Fracture, Shot, Cement Squeeze Record (Amount and Kind of Material Used)	Depth
.....			
.....			
.....			

TUBING RECORD	Size	Set At	Packer at	Liner Run	☐ Yes ☐ No
---------------	------	--------	-----------	-----------	--

Date of First Production Producing Method
☐ Flowing ☐ Pumping ☐ Gas Lift ☐ Other (explain).....

