KANSAS


FORM 51 5M 6-46 PETROL

Barton county

Section 18 Township 16 Range 13-W

Well No. #4, Bitter "C"

Company Cities Service Oil Company

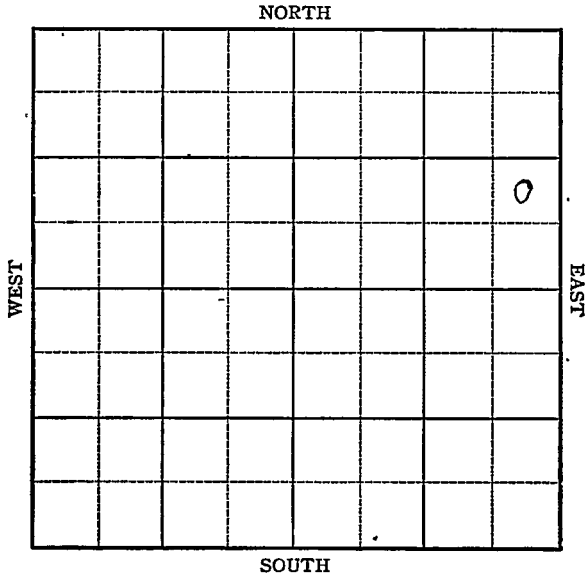

FORM 252-A
5M 6-46 PETROL KANSAS

Barton County

Sec. 18 Twp. 16 R. 13W

Well No. #4 Bitter "C" Farm

Cities Service Company

Susank


_____ Ft. from N. Line

990 Ft. from S. Line

330 Ft. from E. Line

_____ Ft. from W. Line

NE SE NE

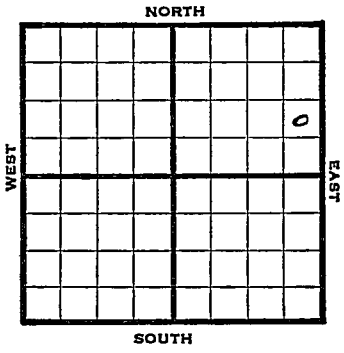

1946 1935 REPORT

9/25 RUR

10/1 8" @ 367
Drlg 2650'

10/8 Arb 374-76 TD
4" @ 3375' RUST

10/15 Lans 3146'

10/22 TD 3378
Pump 7 oil in 4 hrs

10/30 Arb 3374'
4" @ 3375'
TD 3378'
500 Acid
Pump 107 POT
39 Grav.

COMPLETED

FORM 26 200 BKS. 2-44 PETROL

KANSAS Kansas Pool Name Susank

Map No. 23 Sec. 18 Twp. 16 R. 13W


Well No. 4 Bitter "C"

Cities Service Company

FIRST REPORT Contractor

NE SE NE

SECTION PLAT

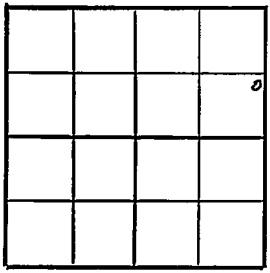

____ Ft. from N. Line

990 Ft. from S. Line

330 Ft. from E. Line

____ Ft. from W. Line

Barton County

Location

Rig up

Drilling and Remarks:

R U R

RECORD

Cased ____ in., ____ ft.

Sand

Gas

Oil

Total Depth

PRODUCTION

1st 24 hrs. Nat.

1st 24 hrs. after shot

Gas ____ Cu. Ft.

Dry Hole

Abandoned

Date

SEP 25 1946 19

S. J. LEWIS Scout

Form 26 200 Bks. 10-46 Petrol

Susank Pool

Kansas

Map No. 73 Sec. 18 Twp. 16 R. 13W

Well No. 4 Bitter "C"


Cities Service Company

COMPLETED Contractor

NE SE NE

E 1/1 725

SECTION PLAT

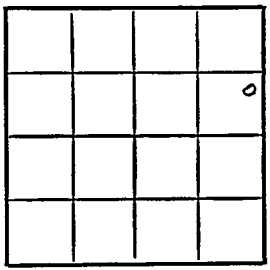

____ Ft. from N. Line

990 Ft. from S. Line

330 Ft. from E. Line

____ Ft. from W. Line

Barton County

Location

Rig up

Drilling and Remarks:

RT 3374

4" @ 3375.

5000 cu ft

Pump 107 BO

99% Gty

RECORD

Cased ____ in., ____ ft.

Sand

Gas

Oil

Total Depth 3378'

PRODUCTION

1st 24 hrs. Nat.

1st 24 hrs. after shot

Gas ____ Cu. Ft.

Dry Hole

Abandoned

Date

OCT 30 1946 19

S. J. LEWIS Scout