


Section 6 ~~7~~ Township 14 Range 14W ~~15W~~

Well No. # 2 John Brown

Company Henry Miller & Morris Mizel

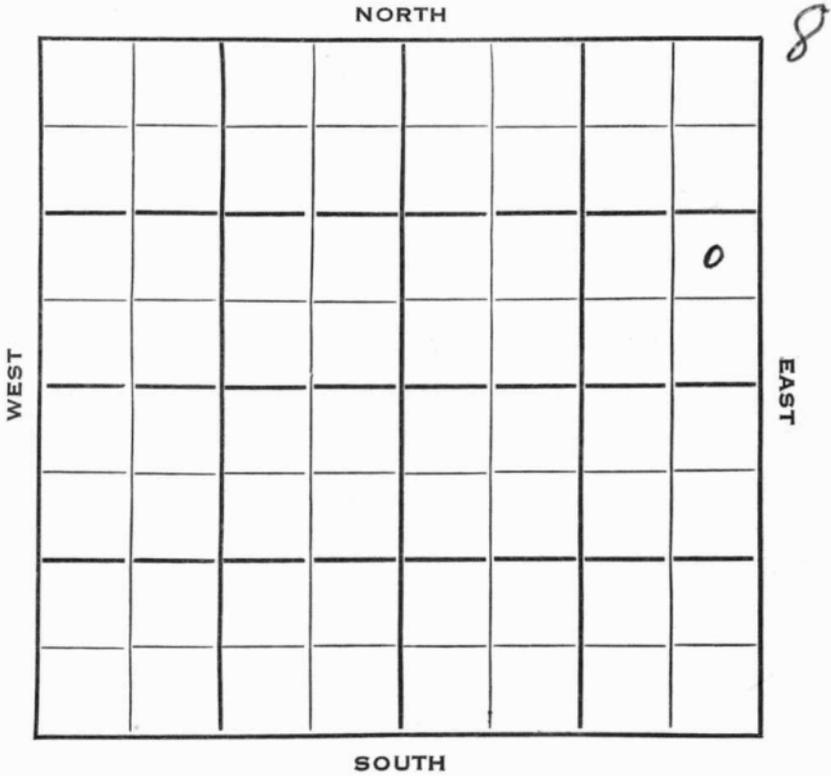

Russell KANSAS

SEC. <u>6</u> <u>1</u>	TWP. <u>14</u>	R. <u>14W</u> <u>15W</u> ✓
---------------------------	----------------	-------------------------------

WELL NO.

2 John Brown

FARM

COMPANY

Henry Miller & Morris Mizel

CONTRACTOR

Mast Drlg.-Contr

Atherton Pool

_____ Ft. from N. Line

990


_____ Ft. from S. Line

330

_____ Ft. from E. Line

_____ Ft. from W. Line

NE SE NE

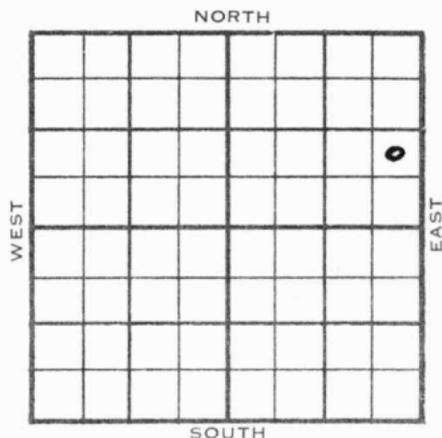

1954	ELEVATION	REPORT
	1866	
6/15	Spdg 6-8-54 Anhy 893 8" @ 903 Drlg. 2078	
6/23	Tarkio 2444', Top 2758', Heeb 2985', Tor 3002', Doug 3018', Lans 3038', B KC 3271', Gorham 3304' RTD 3306' 5" @ 3305'	
630	CO 3306' S/15 go DD 3312, FU 250' fluid 12 hrs. DD 3317' TD 20/3307-12, FU 210' fluid 14 hrs. PB 3213'	
7/7	NR	
7/21	Spdg 6-8-54 D&A TD 3317 Anhy 893 8" @ 903 Tarkio 2444 Top. 3758 Heeb 2985 Tor. 3002 Doug. 3018 Lans. 3058 BKC 3271 Gorham 3304 TD 3306	

Information brought forward

1954

7/21

5" @ 3305 Co to 3306 S/ 15 go DD 3312
FU 250' fluid S/ 15 go DD 3312 F
FU 250' fluid 12 hr. DD 3317
20/ 3307-12 FU 210' fluid 14 hr.
PB 3213 frac S/ 8 bfph 99% wtr.
D&A

ABANDONED

Kansas

Map No. _____ Sec. 6 Twp. 14 R. 14W

Well No. 2 John Brown

Henry Miller & Morris Mizel Company

CORRECTION Contractor

NE SE NE

FIRST REPORT SECTION PLAT

990 Ft. from N. Line

_____ Ft. from S. Line

330 Ft. from E. Line

_____ Ft. from W. Line

			b

Russell County

Location _____

Rig up _____

Drilling and Remarks:

Reported
1-14-15W

RECORD

Cased _____ in., _____ ft.

Sand _____

Gas _____

Oil _____

Total Depth _____

PRODUCTION

1st 24 hrs. Nat. _____

1st 24 hrs. after shot _____

Gas _____ Cu. Ft.

Dry Hole _____

Abandoned _____

Date

JUN 15 1954

19

J. G. McGEHEE

Scout

