


Section 6 Township 14 Range 14W

Well No. #2 Brown

Company Braden Drlg. & Fred Rust

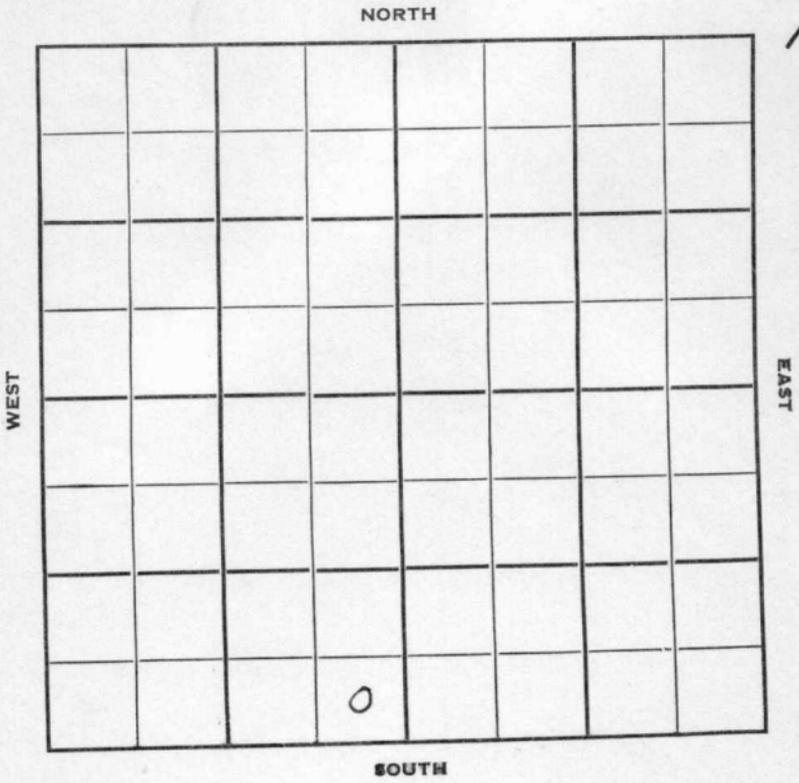

Sec. 6 Twp. 14 R. 14W

Well No. #2 Brown Farm

Braden Drlg. & Fred Rust Company

Braden Drlg. - Contr. Contractor
Gorham Pool


 Ft. from N. Line

330' Ft. from S. Line

330' Ft. from E. Line

 Ft. from W. Line

SE SE SW

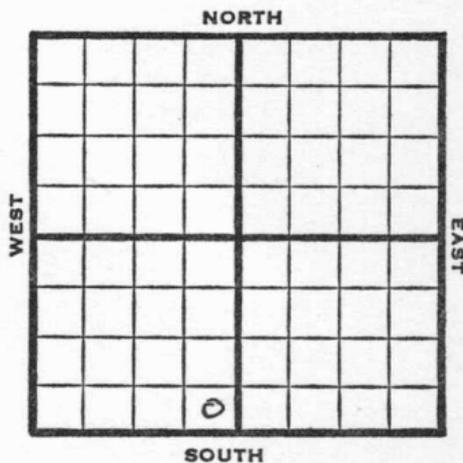

1950 Elev. 1897' REPORT

10/18 Location

11/15 Spud 10-21-50
 Oil Well TD 3340'
 8" @ 52' Anhy 930'
 Top 2793' Heeb. 3021'
 Lans. 3076' Gorham sand 3334'
 5" @ 3335 TD 3340
 HFW SP 3300 12/3254-57
 12/3261-65 1000 A SP 3200
 24/3161-68 1000 A DP to 3300
 Comp. 40 BOPD

COMPLETED

