


KANSAS

Section 6 Township 14 Range 14-W

Well No. #1 Brown "B"

Company Phil-Han
Russell

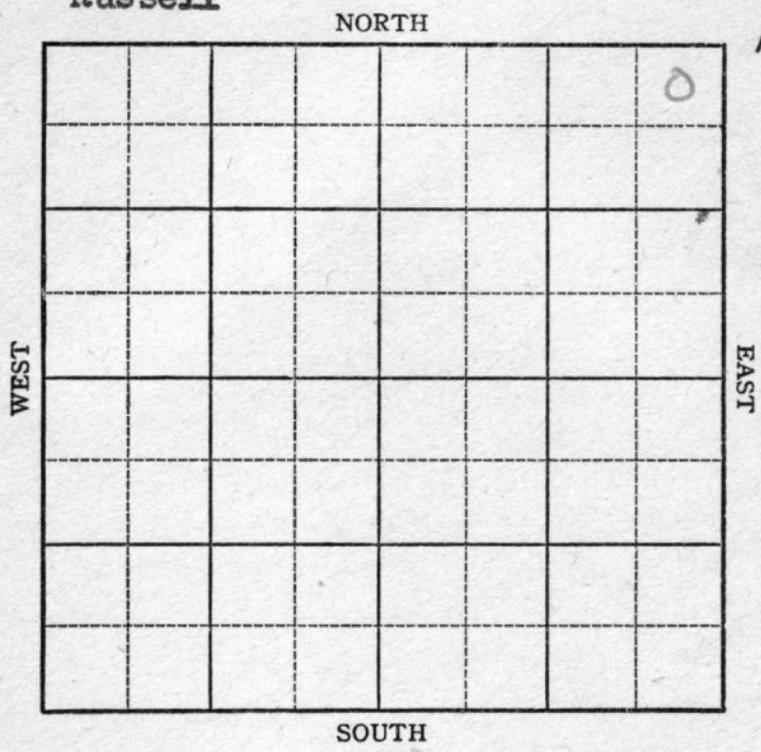

KANSAS

Russe 11 county

Sec. 6 Twp. 14 R. 14W

Well No. 1 Brown "B" Farm _____

Phil-Han Company _____

Hall-Gurney Pool


330 Ft. from N. Line

_____ Ft. from S. Line

330 Ft. from E. Line

_____ Ft. from W. Line

NE/C

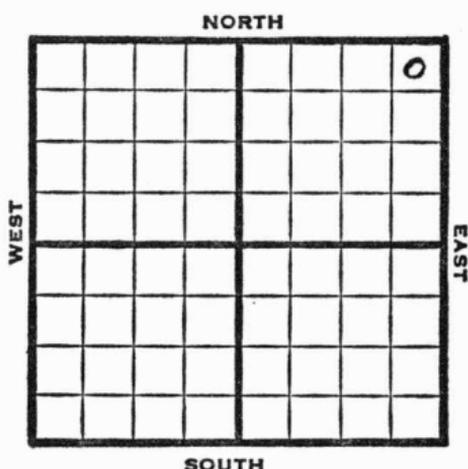

1947

Elev 1859' REPORT

6/25

Location

7/1

Rigging up cable

7/8

Drlg 200'

7-16

15" @ 395

13" @ 543

10" @ 895

Drlg. 125

7/22

Drlg 2055'

7/29

8" @ 2364'

Drlg. 2490'

8/6

6" @ 2545'

Topeka 2750'

Drlg 2915'

8/13

Arbuckle 3295

5" @ 3295

Drlg. 3320

8/20

Arb. 3295'

5" @ 3295'

TD 3345'

Abandoned

ABANDONED

Map No. _____ Sec. 6 Twp. '14 R. 14W

Well No. 1 Brown "B"

Phil-Han Company

FIRST REPORT

Contractor

NE/C

SECTION PLAT

330 Ft. from N. Line

_____ Ft. from S. Line

330 Ft. from E. Line

_____ Ft. from W. Line

Russell County

Location X

Rig up _____

Drilling and Remarks:

RECORD

Cased _____ in., _____ ft.

Sand _____

Gas _____

Oil _____

Total Depth _____

PRODUCTION

1st 24 hrs. Nat. _____

1st 24 hrs. after shot _____

Gas _____ Cu. Ft.

Dry Hole _____

Abandoned _____

Date

JUN 25 1947 19

S. J. LEWIS Scout

Map No. 72 Sec. 6 Twp. 14 R. 14W

Well No. 1 Brown "B"

Phil-Han Company

ABANDONED Contractor

NE/C

E. 1059
SECTION PLAT

330 Ft. from N. Line

_____ Ft. from S. Line

330 Ft. from E. Line

_____ Ft. from W. Line

			<u>5</u>

Russell County

RECORD

Location _____

Cased _____ in., _____ ft.

Rig up _____

Sand _____

Drilling and Remarks:

Gas _____

Oil _____

Total Depth 2345

Per 48295
5' @ 8295

PRODUCTION

1st 24 hrs. Nat. _____

1st 24 hrs. after shot _____

Gas _____ Cu. Ft.

Dry Hole _____

Abandoned _____

Date

AUG 20 1947 19

S. J. LEWIS

Scout