


Russell

FORM 51

Section 6 Township 14 Range 14W KANSAS

Well No. #1 J. Brown

Company Morris Mizel et al

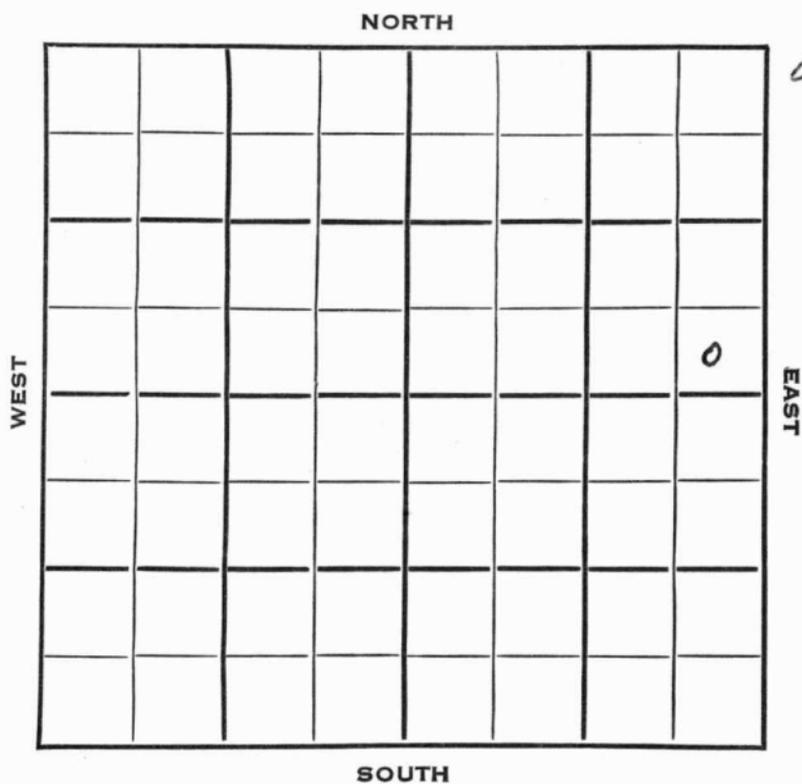

SEC. 6	TWP. 14	R. 14W ✓
-----------	------------	-------------


WELL NO. #1 J. Brown FARM

COMPANY Morris Mizel et al

CONTRACTOR Mast Drlg.

Atherton Pool

_____ Ft. from N. Line
 330 _____ Ft. from S. Line
 330 _____ Ft. from E. Line
 _____ Ft. from W. Line

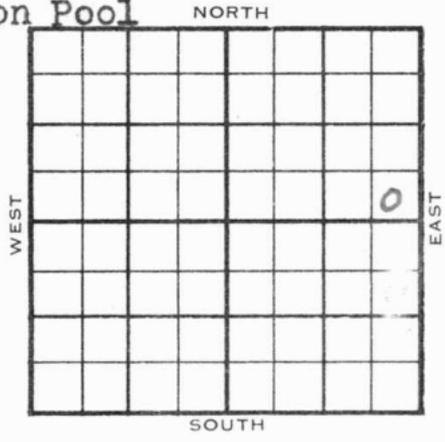

SE SE NE

	ELEVATION	REPORT
1954	1869'	
3/31	Spud 3-28-54	
	Drlg 800'	
4/7	KC 3043'	
	Drlg. 3090'	
5/5	Spud 3-28-54	
	Oil Well	
	TD 3317'	
	KC 3403'	
	TD 3315'	
	5" @ 3312'	
	DD 3317'	
	Gorham Sd 3313'	
	Comp 55 bopd.	

COMPLETED

County **Russell** State **Kansas**

Sec. **6** (Blk.) **14** (Sur.) **14W** Map No.

Operator **Morris Mizel etal.**

Well No. **1** Farm **J. Brown**

Elev. **1869** Location **SE SE NE**

330 Ft. From **S** Line **NE**
330 Ft. From **E** Line Quarter

lst. Report **MAR 31 1954**

Completion

Remarks

Mast Drlg. - Contr.

Spudding Date **3-28-54**

Drlg. Data **Atherton Pool**

drlg. 800

FIRST REPORT

County Russell State Kansas

Sec. 6 (Blk. 14 (Sur. 14W Map No. 14)
 (Twp.) (Rge.)

Operator Morris Mizel etal.

Well No. 1 Farm J. Brown

Elev. 1869 Location SE SE NE

330 Ft. From S Line NE

330 Ft. From E Line Quarter

1st. Report

Completion MAY 5 1954

Remarks Atherton Pool

Mast D_rlg. - Contr.

Spudding Date 3-28-54

Drlg. Data Oilwell TD 3317

KC 3043 TD 3315 5" @ 3312 DD 3317

Gorham sd. 3313 Comp. 55 bopd