


Section 1 Township 33 Range 1E

Well No. 2 Johnson

Company Eekland Drlg.

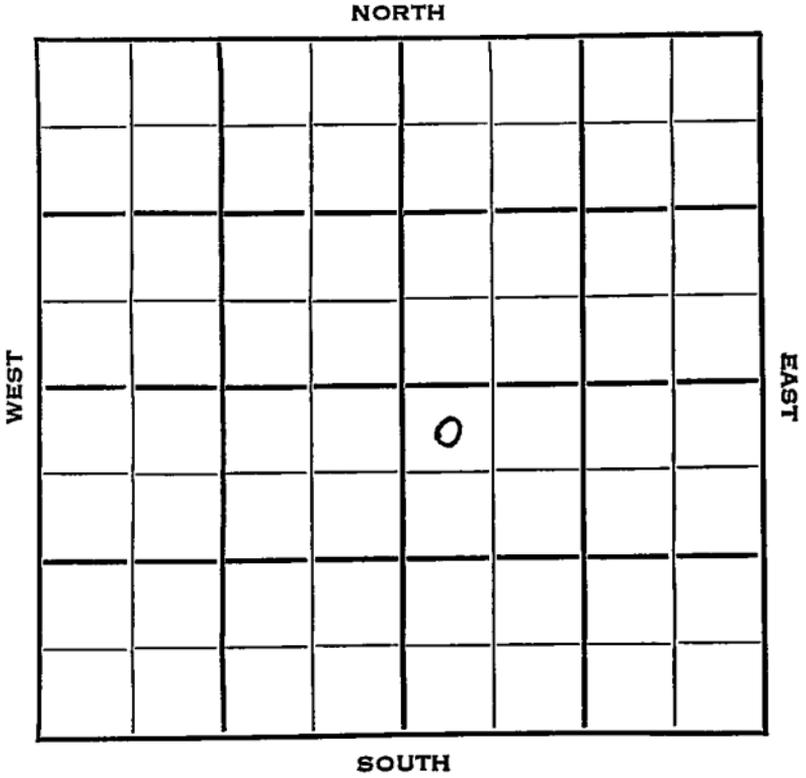

Cowley

KANSAS

SEC. 1	TWP. 33	R. 4E
-----------	------------	----------

WELL NO. #2 Johnson FARM

COMPANY Ecklan Drlg.

CONTRACTOR Eckland


S. Winfield Pool

330 Ft. from N. Line

Ft. from S. Line

Ft. from E. Line

330 Ft. from W. Line

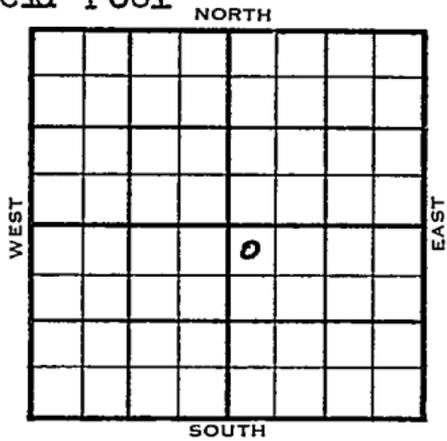

NW NW SE

1954	ELEVATION 1203'	REPORT
------	--------------------	--------

1/6 RUR

9/15 Spud 1-6-54  
Abd.  
TD 3016'  
8" @ 58'  
Hoover 1744', Layton 2395', Cherokee 2875', Bart 2978'  
TD 2985'  
4" @ 2980'  
CO to 2985  
DD 3016  
Temp Abd.

**ABANDONED**

County **Cowley** State **Kansas**

Sec. **1** (Blk. Twp.) **33** (Sur. Rge.) **4E** Map No.

Operator **Eckland Drlg.**

Well No. **2** Farm **Johnson**

Elev. Location **NW NW SE**


**330** Ft. From **N** Line **SE**

**330** Ft. From **W** Line Quarter

1st. Report **JAN 6 '1954**

Completion

Remarks

**Eckland - Contr.**

Spudding Date

Drlg. Data **S. Winfield Pool**

**R U R**

**J. G. McGEHEE**

