


Map No. _____ Sec. 18 Twp. 29 R. 6

Well No. 2 Bush Farm

United Producing & Refining Company

NORTH

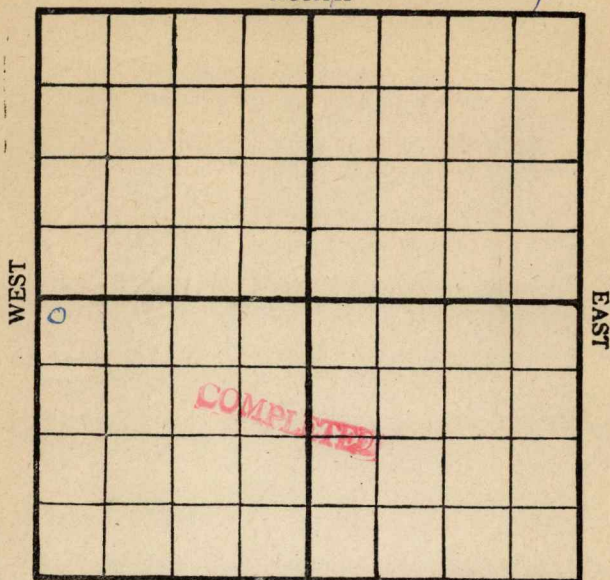

SOUTH

Location _____

Rig Up _____

Drilling Remarks:

Drilling Remarks:

RECORD

PRODUCTION

Cased _____ in. _____ ft.

1st 24 hrs. Nat. _____

Sand _____

1st 24 hrs. after shot _____

Gas _____

Gas _____ cu. ft.

Oil _____

Dry Hole _____

Total Depth _____

Abandoned _____

Map No. 11 Sec. 18 Twp. 29 R. 6Well No. 3 BushHammann & Son Company

Contractor

NORTH

WEST

EAST

SOUTH

Location _____

Rig up _____

Drilling and Remarks:

*This should
be visited
Producing &
Refining Co
#2 Bush*

RECORD

Cased _____ in., _____ ft.

Sand _____

Gas _____

Oil _____

Total Depth _____

PRODUCTION

1st 24 hrs. Nat. _____

1st 24 hrs. after shot _____

Gas _____ Cu. Ft.

Dry Hole _____

Abandoned _____

Date

7/10


191

S. C. Cuddy

Scout

Map No. _____ Sec. 18 Twp. 29 R. 6Well No. 2 BushCompany United Producing

Contractor _____

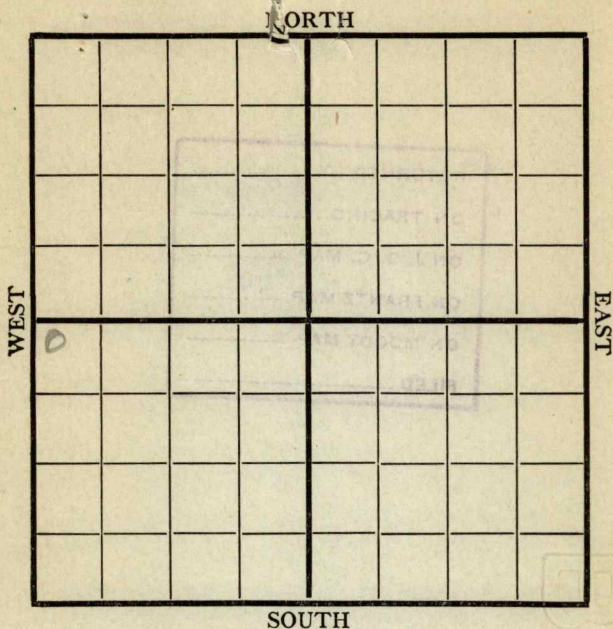

Location _____

Rig up _____

Drilling and Remarks:

Corrected

RECORD

Cased _____ in., _____ ft.

Sand _____

Gas _____

Oil _____

Total Depth _____

PRODUCTION

1st 24 hrs. Nat. _____

1st 24 hrs. after shot _____

Gas _____ Cu. Ft.

Dry Hole _____

Abandoned _____

Date

7/10 191 S. C. Carley Scout

Map No. 111 Sec. 18 Twp. 29 R. 6

Well No. 2 Bush
United Producers Company

Contractor

NORTH

WEST

EAST

SOUTH

Location _____

Rig up _____

Drilling and Remarks:

RECORD

Cased _____ in., _____ ft.

Sand_____

Gas

Oil _____

Total Depth_____

PRODUCTION

1st 24 hrs. Nat. _____

1st 24 hrs. after shot-----

Gas _____ Cu. Ft.

Dry Hole

Abandoned.....


FIRST REPORT

Date _____

6/29 1918. Cardy Scout

Map No. K 11 Sec. 18 Twp. 29 R. 6Well No. 2 BunchUnited Pro & Ref CompanyDyson & Hyle ContractorAugust NORTH Kennett

WEST

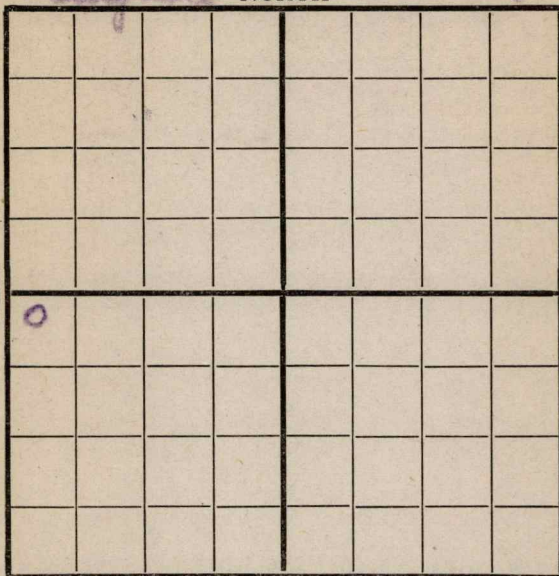

EAST

SOUTH

Location _____

Rig up _____

Drilling and Remarks:

Spindling

RECORD

Cased _____ in., _____ ft.

Sand _____

Gas _____

Oil _____

Total Depth _____

PRODUCTION

1st 24 hrs. Nat. _____

1st 24 hrs. after shot _____

Gas _____ Cu. Ft.

Dry Hole _____


Abandoned _____

Date

1903 191 8 Quincy Scout

Map No. K11 Sec. 18 Twp. 29 R. 6Well No. 2 BushUnited Producing Company

Contractor

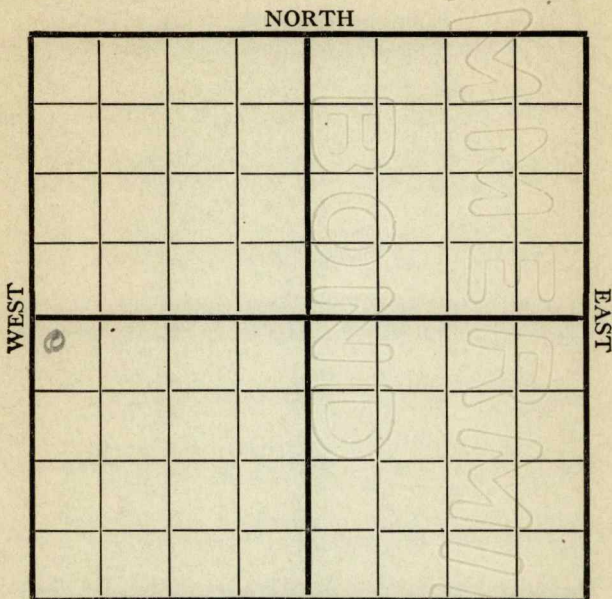

SOUTH

200' N - 200' W

Location _____

Rig up _____

Drilling and Remarks:

350**RECORD**

Cased _____ in., _____ ft.

Sand _____

Gas _____

Oil _____

Total Depth _____

PRODUCTION

1st 24 hrs. Nat. _____

1st 24 hrs. after shot _____

Gas _____ Cu. Ft.

Dry Hole _____

Abandoned _____

Date

10/30 1918 Carley

Scout

Map No. K11 Sec. 18 Twp. 29 R. 6Well No. 2 Bush
United Producers Company
Contractor

NORTH

WEST

EAST

SOUTH

200 N - 200 W

Location _____

Rig up _____

Drilling and Remarks:

590

RECORD

Cased _____ in., _____ ft.

Sand _____

Gas _____

Oil _____

Total Depth _____

PRODUCTION

1st 24 hrs. Nat. _____

1st 24 hrs. after shot _____

Gas _____ Cu. Ft.

Dry Hole _____

Abandoned _____

Date

11/6

191

S. C. C. C.

Scout


Map No. 1511 Sec. 18 Twp. 29 R. 6Well No. 3 BushUnited Pro & Ref Company

Contractor

NORTH

WEST

EAST

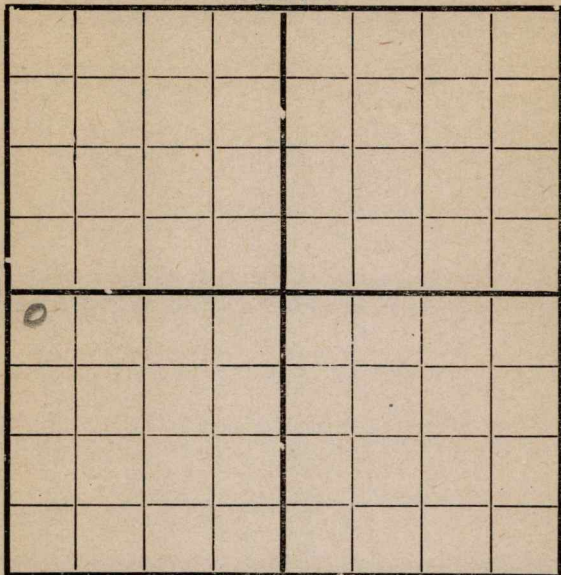

SOUTH

RECORD

Location _____

Cased _____ in., _____ ft.

Rig up _____

Sand _____

Drilling and Remarks:

Gas _____

Oil _____

Total Depth _____

PRODUCTION

1st 24 hrs. Nat. _____

1st 24 hrs. after shot _____

Gas _____ Cu. Ft.

Dry Hole _____

Abandoned _____

Date

11/13

191

J. C. Cundy

Scout


Map No. 111 Sec. 18 Twp. 29 R. 6Well No. 213United Pro Ry Company

Contractor

NORTH

WEST

EAST

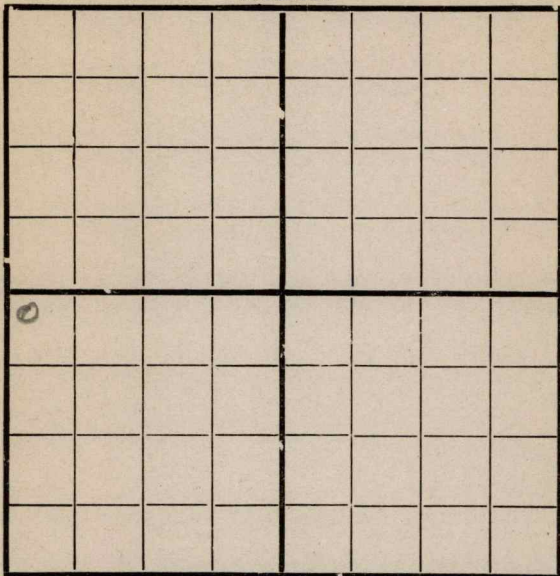

SOUTH

200 X-W

Location _____

Rig up _____

Drilling and Remarks:

22 590

RECORD

Cased _____ in., _____ ft.

Sand _____

Gas _____

Oil _____

Total Depth _____

PRODUCTION

1st 24 hrs. Nat. _____

1st 24 hrs. after shot _____

Gas _____ Cu. Ft.

Dry Hole _____

Abandoned _____

Date

11/20 8

191

Condy

Scout


Map No. K 11 Sec. 18 Twp. 29 R. 6Well No. 2 BushUnited Protry Company

Contractor

NORTH

WEST

EAST

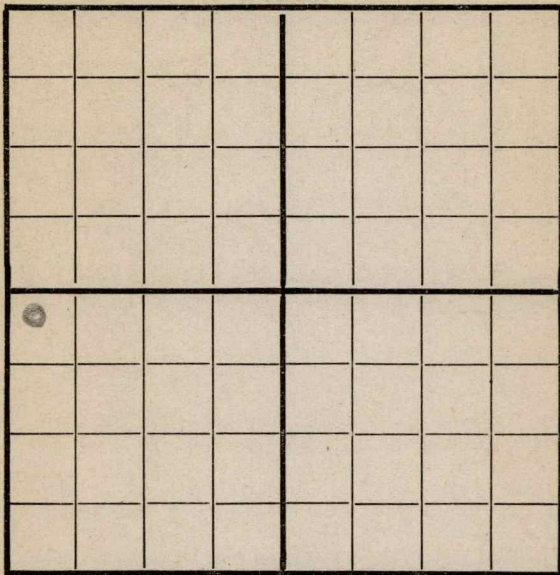

SOUTH

200 N-W

Location _____

Rig up _____

Drilling and Remarks:

800

RECORD

Cased _____ in., _____ ft.

Sand _____

Gas _____

Oil _____

Total Depth _____

PRODUCTION

1st 24 hrs. Nat. _____

1st 24 hrs. after shot _____

Gas _____ Cu. Ft.

Dry Hole _____

Abandoned _____

Date

11/27

191

J. C. Coney

Scout


Map No. K11 Sec. 18 Twp. 29 R. 6Well No. 2 BushUnited Pro & Ry Company

Contractor

NORTH

WEST

EAST

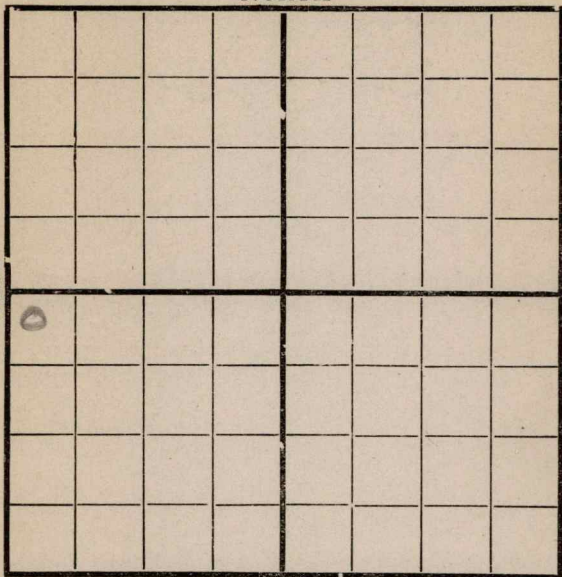

SOUTH

Location _____

Rig up _____

Drilling and Remarks:

1350

RECORD

Cased _____ in., _____ ft.

Sand _____

Gas _____

Oil _____

Total Depth _____

PRODUCTION

1st 24 hrs. Nat. _____

1st 24 hrs. after shot _____

Gas _____ Cu. Ft.

Dry Hole _____

Abandoned _____

Date

12/4 J. C. Cordy 191 _____ Scout


Map No. 1511 Sec. 18 Twp. 29 R. 6Well No. 2 BushUnited P & R Company

Contractor

NORTH

WEST

EAST

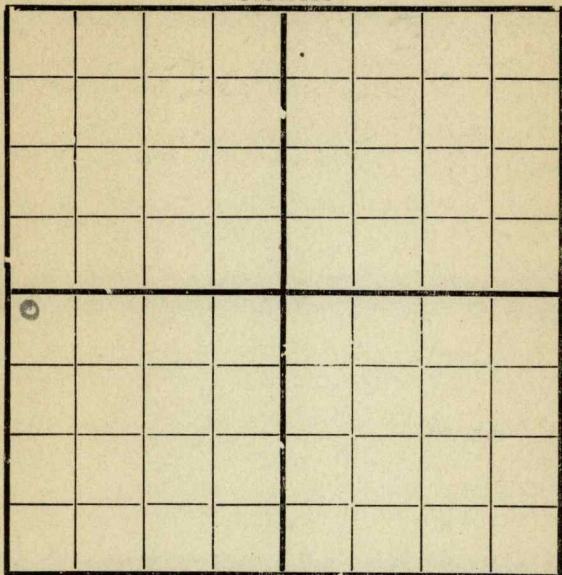

SOUTH

RECORD

Location _____

Cased _____ in., _____ ft.

Rig up _____

Sand _____

Drilling and Remarks:

Gas _____

Oil _____

Total Depth _____

PRODUCTION

1st 24 hrs. Nat. _____

1st 24 hrs. after shot _____

Gas _____ Cu. Ft.

Dry Hole _____

Abandoned _____

Date

12/11 191 S. C. C. C. Scout


Map No. *K11* Sec. *18* Twp. *29* R. *6*Well No. *213*Company *United Prookey*

Contractor

NORTH

WEST

EAST

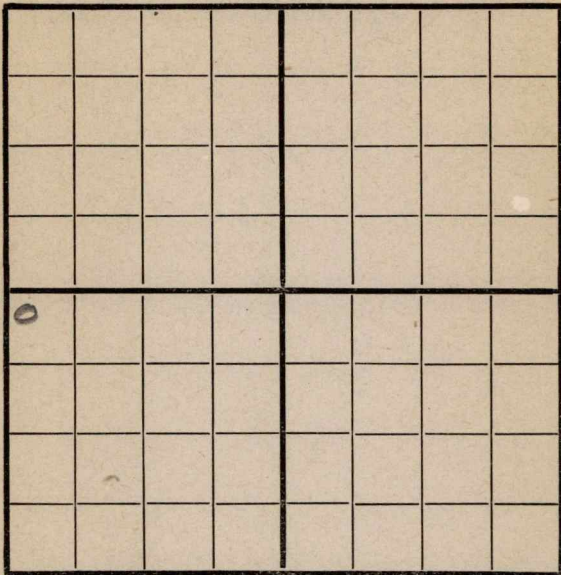

SOUTH

Location _____

Rig up _____

Drilling and Remarks:

Collapsed
Casing
1540

RECORD

Cased _____ in., _____ ft.

Sand _____

Gas _____

Oil _____

Total Depth _____

PRODUCTION

1st 24 hrs. Nat. _____

1st 24 hrs. after shot _____

Gas _____ Cu. Ft.

Dry Hole _____

Abandoned _____

Date

12/25-8 *Casing* Scout


Map No. K 11 Sec. 18 Twp. 29 R. 6Well No. 31 BushUnited Pro & Ray Company

Contractor

NORTH

WEST

EAST

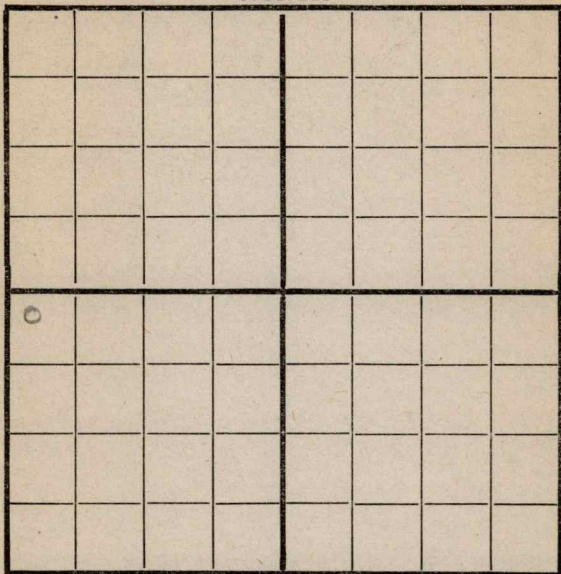

SOUTH

200 N + W

Location _____

Rig up _____

Drilling and Remarks:

SD 1540

RECORD

Cased _____ in., _____ ft.

Sand _____

Gas _____

Oil _____

Total Depth _____

PRODUCTION

1st 24 hrs. Nat. _____

1st 24 hrs. after shot _____

Gas _____ Cu. Ft.

Dry Hole _____

Abandoned _____

Date

1/22 1919 C. C. Cady Scout


Map No. K11 Sec. 18 Twp. 29 R. 6Well No. 2 BushUnited P. & R. Company

Contractor

NORTH

WEST

EAST

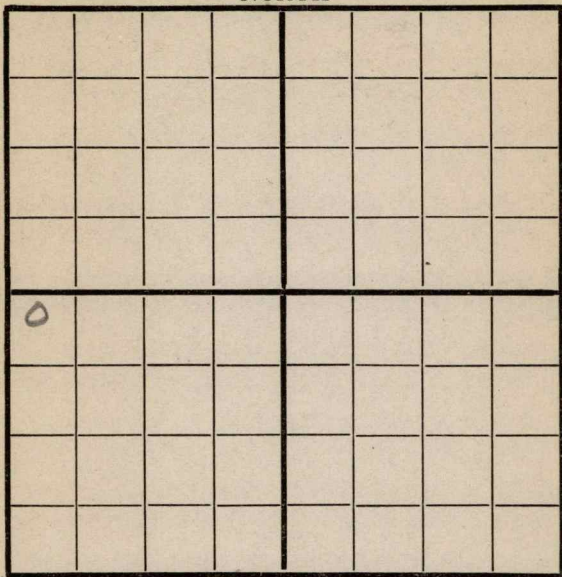200 N-W SOUTH

Location _____

Rig up _____

Drilling and Remarks:

2110'

RECORD

Cased _____ in., _____ ft.

Sand _____

Gas _____

Oil _____

Total Depth _____

PRODUCTION

1st 24 hrs. Nat. _____

1st 24 hrs. after shot _____

Gas _____ Cu. Ft.

Dry Hole _____

Abandoned _____

Date


3/8191 9

Pyle

Scout

Map No. K 11 Sec. 18 Twp. 29 R. 6Well No. 2 BushUnited Pro. & Ref. Company

Contractor

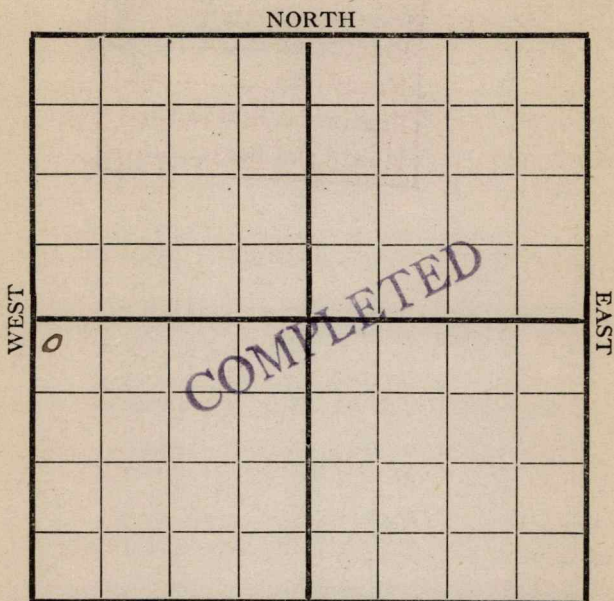200 N-W

Location _____

Rig up _____

Drilling and Remarks:

RECORD

Cased _____ in. _____ ft.

Sand 2769 - 2775

Gas _____

Oil _____

Total Depth _____

PRODUCTION

1st 24 hrs. Nat. 75 bbls

1st 24 hrs. after shot _____

Gas _____ Cu. Ft.

Dry Hole _____

Abandoned _____

Date

4/231919Pyle

Scout