


Russell

KANSAS

SECTION 8 TOWNSHIP 14 RANGE 11W

WELL NO. #2 Krug

COMPANY Barnett Oil

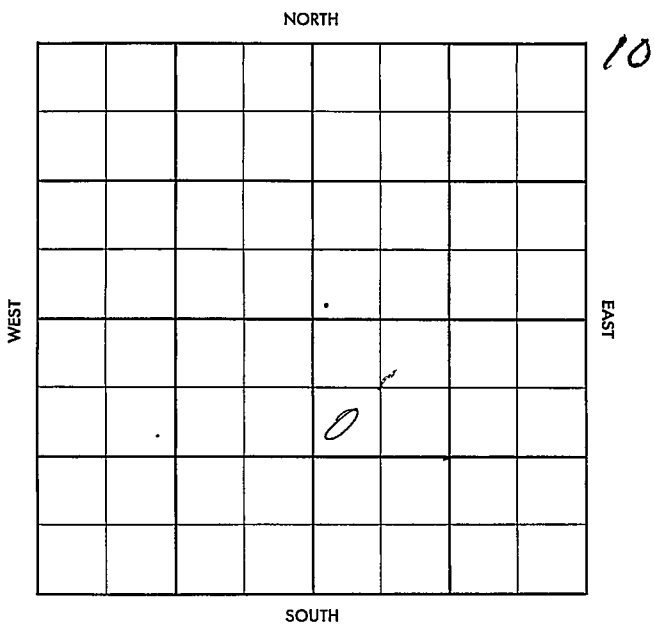

SEC 8	TWP 14	R 14W
----------	-----------	----------

WELL NO ~~#####~~ #2 Krug FARM

COMPANY Barnett Oil

CONTRACTOR

Hall-Gurney


_____ Ft from N Line

_____ Ft. from S. Line

_____ Ft. from E. Line

_____ Ft. from W Line

SW NW SE

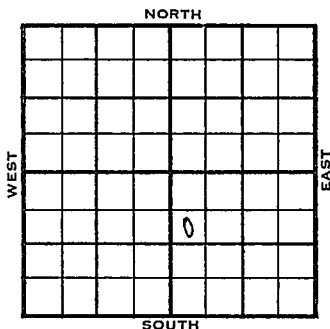

1956	ELEVATION ## 1879	REPORT
------	---------------------------------	--------

3-28 Comm. 3-24-56
8" @ 350 w/ 200
Drlg. 825

4-25 DST 3134-38 op 1 hr. rec. 120' socm,
360' black wtr., scum oil, 60' clear
wtr., BHP failed, SSO 3144-56.
DST 3205-15 op 1 hr. rec. 280' salt
wtr. 680#
5 1/2" @ 3229 w/125
DD 3241, 500 A, 5 bw 3 hrs. PB 3164
16/ 3142-46
S/3 bf, 80% wtr., 18 hrs., 18/ 3133-36
S/3 bf, 80% wtr.
CO 3152, 12/ 3142-46, 4 gw 2 hrs.,
500 A
S/ 20 bo, 203 bw, 15 hrs.
PB 3063, 12/ 3050-54, 500 A
S/ 1 bo, 2 bwph,
Comp. ~~XX~~ 25 bopd, 40 bw
Howard 2723
Tp. 2761
H. 2990
Tr. 3010
Dg. 3025
L. 3049
TD 3231'

COMPLETED

County Russell Elev. 1879
 Sec. 8 Rge. 14W
 Company Barnett Oil
 FarmName Krug No. 2

TOPS	DEPTH	LOG	DATUM	Loc. in Sec.
Anh. <u>How</u>	<u>2723</u>			<u>SW NW SE</u>
TP.	<u>2761</u>			
H.	<u>2990</u>			
Tr.	<u>3010</u>			
Dg.	<u>3025</u>			
Bl.				
L.	<u>3049</u>		<u>1170</u>	
K.C.				Geol.
B.K.C.				Contr.
Ce.				
C.				
M.				
M.				Pool
K.				<u>Hall-Gurney</u>
Mz.				
Me.				
V.				
S.				
S.				
A.				
R.				
PE.				
G.				
TD.	<u>3231</u>			

COMPLETE

Date Comm. 3-24-56 APR 25 1956
8" @ 350/200 DST. 3134-38 open 1 hr.
rec. 120' soem 360' black wtr., scum
oil 60' clear wtr. BHP failed
SSO 3144-56 DST 3205-15 open 1 hr.
rec. 280' salt wtr. 680# 5 1/2" @ 3229/125
DD 3241 500 A 5 bw. 3 hr. PB 3164
16/ 3142-46 S/ 3 bf 80% wtr.
18 hr. 18/ 3133-36 S/ 3 bf 80% wtr.

OVER