
KANSAS
FORM 51 5M 1-42 PETROL

Russell

Section 8 Township 14 Range 14-W

Well No. #2 Krug

Company Alva Billings

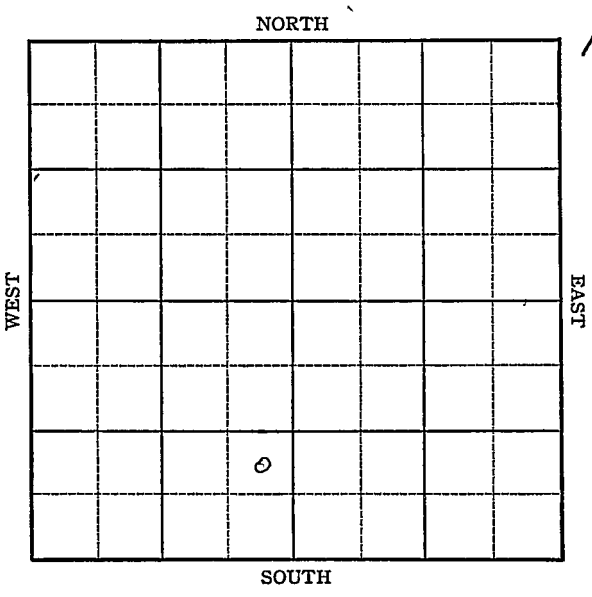

Form 252-A
5M 5-42 Petrol


KANSAS

Russell

Sec. 8 Twp. 14 R. 14-W

Well No. #2 Krug Farm

Alva Billings Company

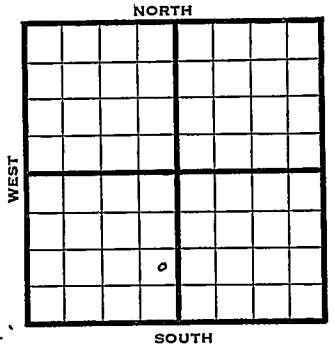

____ Ft. from N. Line

990 Ft. from S. Line

330 Ft. from E. Line

____ Ft. from W. Line

Elev. 1885

1943	REPORT
3/31	Move in material
4/7	Machine
4/14	15" @ 20' Drlg. 585'
4/21	12" @ 485' Drlg. 570'
4/28	10" @ 900' Drlg. 1170'
5/5	Anhy 895 Drlg. 1925'
5/12	Drlg. 2425
5/19	Drlg. 2780 8" @ 2500'
5/26	Drlg. 3005'
6/2	Dodge 3011 Lans 3049 7" @ 3049 WOC.
6/9	1000 acid.
6/16	Swab 145 oil Temp. Pot.
6/23	" "
6/30	" "
7/7	" "
7/15	" "

OVER

1943

7/21 Swb 145 oil tem pob

7/28 Lans 3049
7" @ 3049'
T.D. 3089'
1000 gal. acid
Pump 346 Pot.
Gravity 40

COMPLETED

Form 26 200 Bks 5-42 Petrol

KANSAS

Russell

Map No. 22 Sec. 8 Twp. 14 R. 14W


Well No. 2 Krug

Alva Billings Company

FIRST REPORT Contractor

NE SE SW

SECTION PLAT

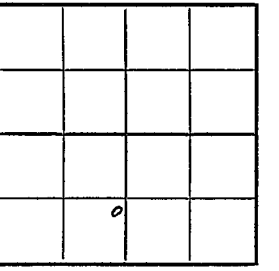

____ Ft. from N. Line

990 Ft. from S. Line

330 Ft. from E. Line

____ Ft. from W. Line

No Pool name

Location

Rig up

Drilling and Remarks:

Move in machine

RECORD

Cased ____ in., ____ ft.

Sand

Gas

Oil

Total Depth

PRODUCTION

1st 24 hrs. Nat.

1st 24 hrs. after shot

Gas ____ Cu. Ft.

Dry Hole

Abandoned

Date

MAR 3 1 1943 19

S. J. LEWIS Scout

Form 26 200 Blks 5-42 Petrol

KANSAS Russell

Map No. 12 Sec. 8 Twp. 14 R. 14W

Well No. 2 Krug


Alva Billings Company

COMPLETED

Contractor

NE SE SW

SECTION PLAT

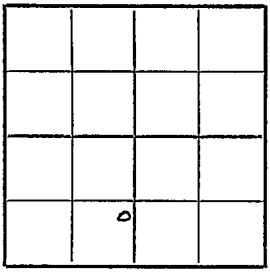

____ Ft. from N. Line

990 Ft. from S. Line

330 Ft. from E. Line

____ Ft. from W. Line

KRUG POOL

Location

Rig up

Drilling and Remarks:

Lime 3049

TD 3049

1000 acid

Pump 846 Bbl.

40 Gr

RECORD

Cased ____ in., ____ ft.

Sand

Gas

Oil

Total Depth 3089

PRODUCTION

1st 24 hrs. Nat.

1st 24 hrs. after shot

Gas ____ Cu. Ft.

Dry Hole

Abandoned

Date

JUL 28 1943 19

S. J. LEWIS Scout