


Section 30 Township 14 Range 13-W

Well No. 14 Miller

Company J. J. Hall et al

NORTH Hall-Lansing Pool

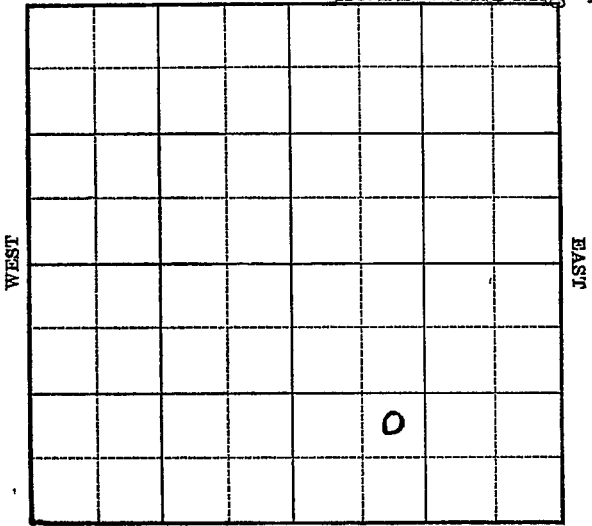

SOUTH

O. W. D. D.

Sec. 30 Twp. 14 R. 13-W

Well No. #14 Miller Farm

J. C. Hall et al Company


(Hall-Lansing)

_____ Ft. from N. Line

990 Ft. from S. Line

_____ Ft. from E. Line

990 Ft. from W. Line

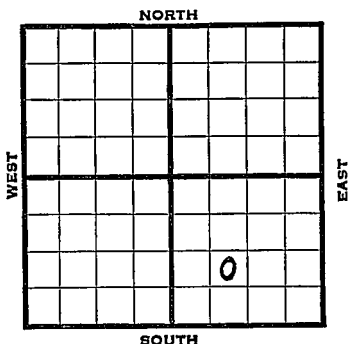

| 1938 | REPORT . O. W. D. D. |
|-------|--|
| 12/21 | 15" - 50' .. 12" - 387' .. |
| | Anhy. 662' . 10" - 667' . |
| | Drlg. 1860' . |
| 12/30 | Shut down . |
| 1939 | |
| 1/6 | Shale 2337' . T. D. 2345' S. G. Shut down . |
| 1/13 | 8" - 2251' . Gas 2262-66' . T. D. 2345 ' . Test . |
| 1/18 | 8" - 2251' .. Shale 2337' . T. D. 2345' . Est. 1/2 M gas . |
| | COMPLETED |
| | OVER |

1939

O. W. D. D.

6/7

OTD 2345

Lans. 2865

7" 2872

T.D. 2925

7000 acid

Pot. 1292 pump

FIRST REPORT



COMPLETED

Map No. 72 Sec. 30 Twp. 14 R. 13WWell No. 14 MillerJ. J. Hall et al

Company

Contractor

FIRST REPORT

NE SW SE

_____ Ft. from N. Line

990 Ft. from S. Line

_____ Ft. from E. Line

990 Ft. from W. Line

SECTION PLAT

| | | | |
|--|--|---|--|
| | | | |
| | | | |
| | | | |
| | | o | |

HALL-LANSING POOL

Location _____

Rig up _____

Drilling and Remarks:

15" - 5012" - 387Anhy. 66210" - 667Drlg. 1860

RECORD

Cased _____ in., _____ ft.

Sand _____

Gas _____

Oil _____

Total Depth _____

PRODUCTION

1st 24 hrs. Nat. _____

1st 24 hrs. after shot _____

Gas _____ Cu. Ft.

Dry Hole _____

Abandoned _____

Date

DEC 21 1938 19H. D. Hatfield Scout

Russell **KANSAS**

Map No. 72 Sec. 30 Twp. 14 R. 13W

Well No. 14 Miller

J. J. Hall etal Company

Contractor

COMPLETED

SECTION PLAT

NE SW SE

_____ Ft. from N. Line

990 Ft. from S. Line

_____ Ft. from E. Line

990 Ft. from W. Line

| | | | |
|--|--|---|--|
| | | | |
| | | | |
| | | | |
| | | 0 | |

Hall Lansing Pool

Location _____

Rig up _____

Drilling and Remarks:

Est 1/2 M. gas

RECORD

Cased 8 in., 225/ft.

Sand shale 2337

Gas _____

Oil _____

Total Depth 2345

PRODUCTION

1st 24 hrs. Nat. _____

1st 24 hrs. after shot _____

Gas _____ Cu. Ft.

Dry Hole _____

Abandoned _____

Date

JAN 18 1939 19

H. D. Hatfield

Scout

Russell

Map No. _____ Sec. 30 Twp. 14 R. 13WWell No. 14 E. J. MillerJ. J. Hall et al

Company

FIRST REPORT

Contractor

✓
COMPLETED

SECTION PLAT

| | | | |
|--|--|--|--|
| | | | |
| | | | |
| | | | |
| | | | |

NE SW SE

_____ Ft. from N. Line

990 Ft. from S. Line

_____ Ft. from E. Line

990 Ft. from W. LineHall Pool

Location _____

Rig up _____

Drilling and Remarks:

OW IIIOld TD 2345Loss 28657" @ 28727000 acidPs. 1292 Pump

RECORD

Cased _____ in., _____ ft.

Sand _____

Gas _____

Oil _____

Total Depth 2925

PRODUCTION

1st 24 hrs. Nat. _____

1st 24 hrs. after shot _____

Gas _____ Cu. Ft.

Dry Hole _____

Abandoned _____

Date

JUN. 7 1939S. J. LEWIS

Scout