

KANSAS


Cowley

FORM 51 5M BR1X

Section 1 Township 33 Range 4E

Well No. #1, Wise

Company W. H. Lassen et al. Rocks OPERATION

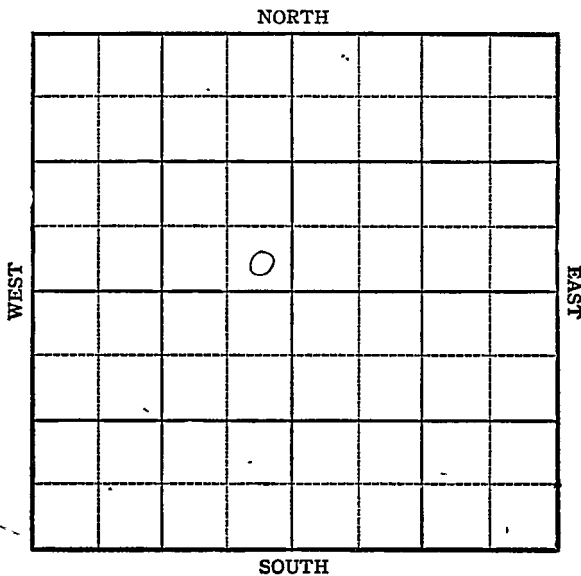

Cowley

Sec. 1 Twp. 33 R. 4E

Well No. #1 Wise Farm
Rocks Operation
W.H. Lassen et al. Company

Miscellaneous


 Ft. from N. Line

330 Ft. from S. Line

330 Ft. from E. Line

 Ft. from W. Line

Q.W. 1210

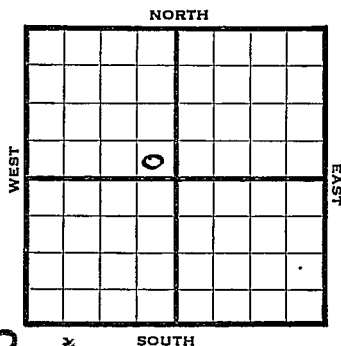

1944

REPORT

5/24	Machine
5/31	"
6/7	"
6/15	"
6/21	"
6/28	"
7/12	"
7/19	"
7/26	"
8/2	"
8/9	"
8/16	"
8/23	"
8/30	"
9/8	"
9/13	"
9/21	"
9/28	"
10/4	"
10/11	"
10/18	"
10/25	"
11/1	"
11/8	"

OVER

1944
 11/16 Machine
 11/24 "
 11/29 "
 12/6 "
 12/14 "
 12/21 "
 12/29 "
 1945
 1/3 "
 1/10 "
 1/17 Spud 30'
 1/26 Drlg. 505'
 1/31 800' Shutdown
 2/7 15" @ 200
 900 fsg
 2/14 " "
 2/21 Drlg 910
 2/28 12" @ 980 Drlg
 3/7 1550 SD
 3/14 " "
 3/23 " "
 3/29 10" @ 1647' CO
 4/5 10" @ 1716
 Drlg. 1765
 4/12 Elgin sd 1888-20 TD
 8" @ 1818' S.D.
 4/20 " " # " " "
 4/27 " " " " " "
 5/9 Elgin Sd 1818
 8" @ 1824
 TD 1830
 Pump 20 oil Pot.
 Grav. 41.6

COMPLETED

Pool Name Miscellaneous


KANSAS

Map No. 2 Sec. 1 Twp. 33 R. 4EWell No. 1 WiseW. H. Lassen et al. Company~~FIRST REPORT~~

Contractor

SE NW

SECTION PLAT

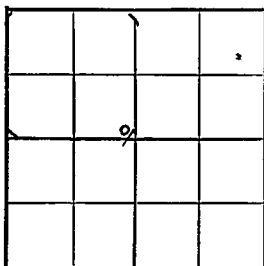 Ft. from N. Line330 Ft. from S. Line330 Ft. from E. Line Ft. from W. LineCowley CountyLocation Rig up

Drilling and Remarks:

Machine

RECORD

Cased in., ft.Sand Gas Oil Total Depth

PRODUCTION

1st 24 hrs. Nat. 1st 24 hrs. after shot Gas Cu. Ft.Dry Hole Abandoned

Date

MAY 24 1944 19S. J. LEWIS Scout

Kansas Pool Name MiscellaneousMap No. 2 Sec. 1 Twp. 33 R. 4EWell No. 1 WiseRooks Operation CompanyCORRECTION Contractor

SE NW

SECTION PLAT

 Ft. from N. Line330 Ft. from S. Line330 Ft. from E. Line Ft. from W. Line

		o	

Cowley
Location Rig up

Drilling and Remarks:

was W.H. Lassen
etal

RECORD

Cased in., ft.Sand Gas Oil Total Depth

PRODUCTION

1st 24 hrs. Nat. 1st 24 hrs. after shot Gas Cu. Ft.Dry Hole Abandoned

Date


MAY 9 1945 19

S. J. LEWIS Scout

Kansas Pool Name MiscellaneousMap No. 2 Sec. 1 Twp. 33 R. 4EWell No. 1 WiseHooks Operation Co. Company**COMPLETED**

Contractor

SE NW

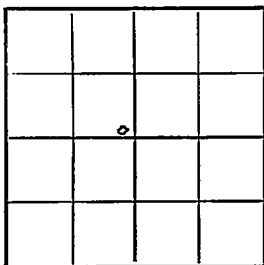E 1/2 10
SECTION PLAT Ft. from N. Line330 Ft. from S. Line330 Ft. from E. Line Ft. from W. Line

Cowley County

Location Rig up

Drilling and Remarks:

Elgin 1818870 1824Pump. 2000 ft. 1824416 ft.**RECORD**Cased in., ft.Sand Gas Oil Total Depth 1830**PRODUCTION**1st 24 hrs. Nat. 1st 24 hrs. after shot Gas Cu. Ft.Dry Hole Abandoned

Date

MAY 9 1945 19

S. J. LEWIS

Scout