


Section 1 Township 33 Range 4-E

Well No. #2 Wise

Company Sam Springer

Miscellaneous

NORTH

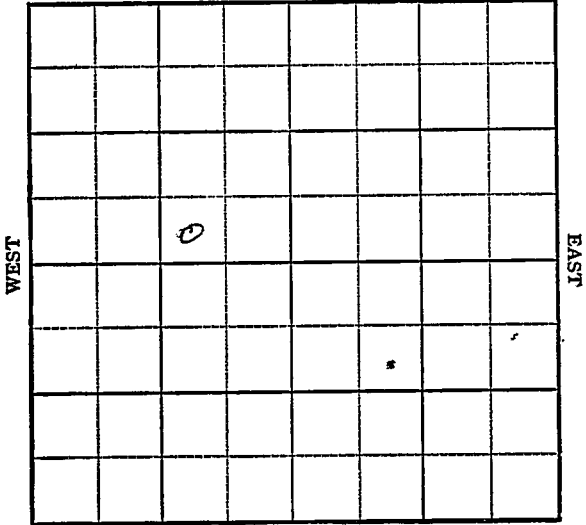

SOUTH

KANSAS

Cowley

Sec. 1 Twp. 33 R. 4E ✓

Well No. #2 Wise Farm
Sam Springer Company

Miscellaneous


 Ft. from N. Line

330' Ft. from S. Line

990' Ft. from E. Line

 Ft. from W. Line

SW SE NW

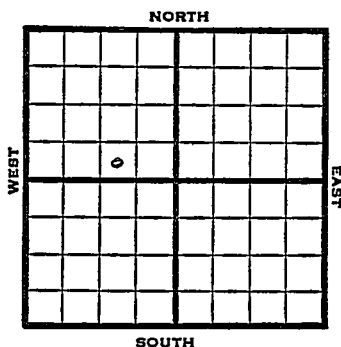

1948

Eli 1234'

R E P O R T

12/1

8" @70'
Drlg. 1800'

12/6

Miss 3098'
TD 3103'
5" @ 3102'

12/15

TD 3134'
Miss 3098'
Aband.

ABANDONED

Map No. _____ Sec. 1 Twp. 33 R. 4E

Well No. 2 Wise

Sam Springer Company

FIRST REPORT

Contractor

SW SE NW

SECTION PLAT

_____ Ft. from N. Line

- 330 Ft. from S. Line

990 Ft. from E. Line

_____ Ft. from W. Line

Cowley County

Location _____

Rig up _____

Drilling and Remarks:

8" @ 70

drlg. 1800

RECORD

Cased _____ in., _____ ft.

Sand _____

Gas _____

Oil _____

Total Depth _____

PRODUCTION

1st 24 hrs. Nat. _____

1st 24 hrs. after shot _____

Gas _____ Cu. Ft.

Dry Hole _____

Abandoned _____

Date

DEC 1 1948

19

S. J. LEWIS Scout

Map No. 2 Sec. 1 Twp. 33 R. 4 E

Well No. 2 Wise

Sam Springer Company

ABANDONED

Contractor

SW SE NW

E 1/2 34
SECTION PLAT

 Ft. from N. Line

330 Ft. from S. Line

990 Ft. from E. Line

 Ft. from W. Line

Cowley County

Location

Rig up

Drilling and Remarks:

Min 2098'

RECORD

Cased in., ft.

Sand

Gas

Oil

Total Depth 8124

PRODUCTION

1st 24 hrs. Nat.

1st 24 hrs. after shot

Gas Cu. Ft.

Dry Hole

Abandoned

Date

DEC 15 1948

19

S. J. LEWIS

Scout