

KANSAS


Cowley County

FORM 51 5M PETROL

Section 1 Township 33 Range 4E

Well No. 2 Wise

Company Rooks Oil Operating

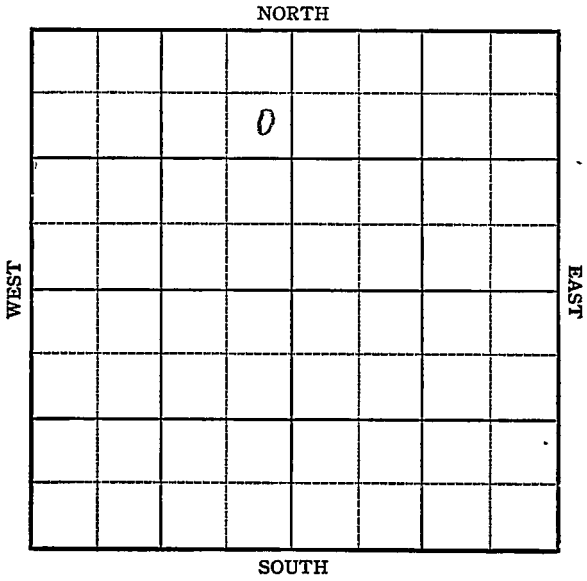

Sec. 1 Twp. 33 R. 4E

Well No. 2 Wise Farm _____

Rooks Oil Operating Company _____


Miscellaneous

990 Ft. from N. Line

_____ Ft. from S. Line

330 Ft. from E. Line

_____ Ft. from W. Line

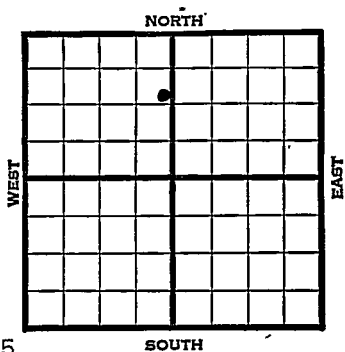

SE NE NW Elev. 1205

1945 REPORT

- 5/9 Location was W. H. Lassen etal
- 5/17 Rig
- 5/24 "
- 5/31 Drlg. 233
- 6/8 15" @ 490 Drlg. 1020
- 6/14 12" @ 1125
- 6/21 1542 Run 10"
- 10" @ 1542
- 8" @ 1908
- 6/28 Drlg 2035
- 2245 UR 8"
- 7/3 2" @ 2234
- KC 2540
- Drlg. 2550
- 7/11 6" @ 2628
- Drlg. 2850'
- 7/19 Miss. 3090
- TD 3135
- 1500' oil
- 5" @ 3108' WOC
- 7/26 " " " "
- 8/3 " " " "
- 8/8 " " " "
- 8/15 " " " "
- 8/22 " " " "
- 8/29 " " " "
- 9/5 " " " "

OVER

1945

9/12 Miss. 3090
TD 3135'

ABANDONED

Kansas Pool Name MiscellaneousMap No. 2 Sec. 1 Twp. 33 R. 4EWell No. 2 WiseRooks Oil Operating Company

FIRST REPORT

Contractor

SE NE NW


SECTION PLAT

990 Ft. from N. Line

_____ Ft. from S. Line

330 Ft. from E. Line

_____ Ft. from W. Line

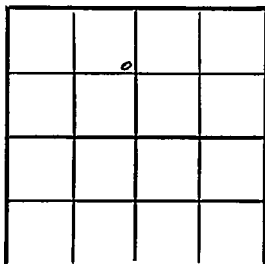

Cowley County

Location X

Rig up _____

Drilling and Remarks:

was W. H. Lassen
etal

RECORD

Cased _____ in., _____ ft.

Sand _____

Gas _____

Oil _____

Total Depth _____

PRODUCTION

1st 24 hrs. Nat. _____

1st 24 hrs. after shot _____

Gas _____ Cu. Ft.

Dry Hole _____

Abandoned _____

Date

MAY 9 1945 19 _____ S. J. LEWIS Scout

Miscellaneous

KANSAS Kansas

Pool Name

Map No. 2 Sec. 1 Twp. 33 R. 4E

Well No. 2 Wise

Rooks Oil Operating Company

ABANDONED Contractor

SE NE NW

7/1/205
SECTION PLAT

990 Ft. from N. Line

_____ Ft. from S. Line

330 Ft. from E. Line

_____ Ft. from W. Line

	0		

Cowley County

Location _____

Rig up _____

Drilling and Remarks:

Miss 3090

RECORD

Cased _____ in., _____ ft.

Sand _____

Gas _____

Oil _____

Total Depth 3135

PRODUCTION

1st 24 hrs. Nat. _____

1st 24 hrs. after shot _____

Gas _____ Cu. Ft.

Dry Hole _____

Abandoned _____

Date

SEP 12 1945 19

S. J. LEWIS Scout