
Russell KANSAS

Form 51—5M—7-39—Palace

Section 29 Township 14- Range 13-W

Well No. 8 Opdycke

Company Skelly

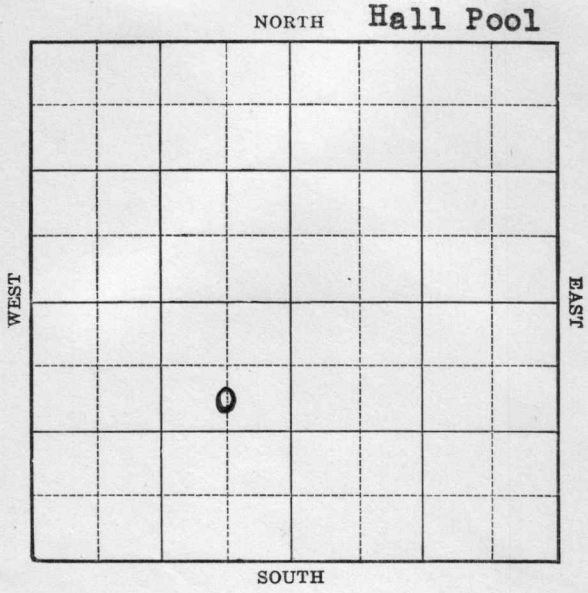

FORM 252-A 5M 4-39 KANSAS Russell

Sec. 29 Twp. 14 R. 13-W

Well No. #8 Opdycke Farm


Skelly Company

990 Ft. from N. Line

Ft. from S. Line

660 Ft. from E. Line

Ft. from W. Line

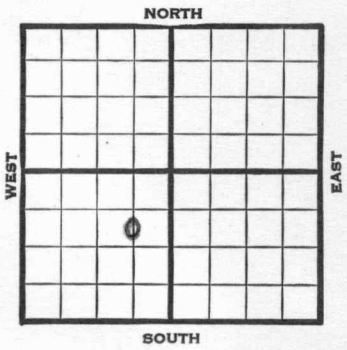

1939	REPORT
8/16	10" - 296' WOC.
8/24	Drlg. 2250'
8/31	Lans. 2892' 6" - 2911' T.D.
	RUST.
9/7	T.D. 2933' 350' oil 12 hours.
9/13	Lans. 2892'
	6" - 2911'
	T.D. 2933'
	4000 acid.
	Potential 988 bbls., Pump.
	COMPLETED

Form 26—1M Bks.—2-29 Russell KANSAS

Map No. 72 Sec. 29 Twp. 14 R. 13W

Well No. 8 Opdycke

Skelly

Company

Contractor

FIRST REPORT

C S L NE SW

990 Ft. from N. Line


Ft. from S. Line

660 Ft. from E. Line

Ft. from W. Line

HALL POOL

SECTION PLAT

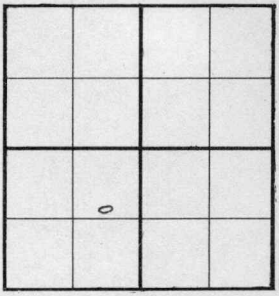

Location

Rig up

Drilling and Remarks:

10" - 296

WOC

RECORD

Cased in., ft.

Sand

Gas

Oil

Total Depth

PRODUCTION

1st 24 hrs. Nat.

1st 24 hrs. after shot

Gas Cu. Ft.

Dry Hole

Abandoned

Date

AUG 16 1939 19

S. J. LEWIS Scout

Form 26—1M Bks.—2-29 Russell KANSAS

Map No. Sec. 29 Twp. 14 R. 13W

Well No. 8 Opdycke

Skelly Company

Contractor

COMPLETED

C S L NE SW

990 Ft. from N. Line


Ft. from S. Line

660 Ft. from E. Line

Ft. from W. Line

HALL POOL

SECTION PLAT

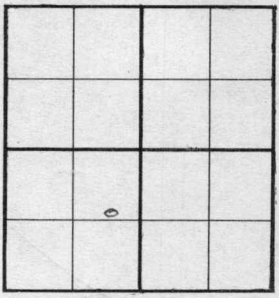

Location

Rig up

Drilling and Remarks:

Lans 2892

6" @ 2911

4000 acid

Pump 988 Bbl.

RECORD

Cased in., ft.

Sand

Gas

Oil

Total Depth 2933

PRODUCTION

1st 24 hrs. Nat.

1st 24 hrs. after shot

Gas Cu. Ft.

Dry Hole

Abandoned

Date

SEP 13 1939 19

S. J. LEWIS Scout