


Section 29 Township 14 Range 13-W

Well No. #10 Opdycke

Company Skelly

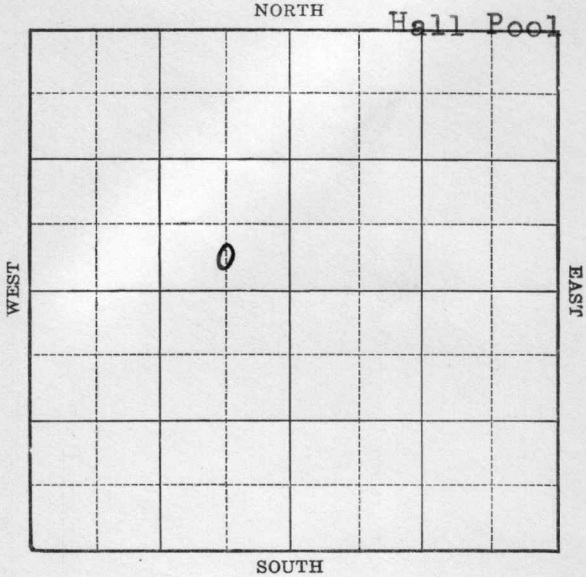

Sec. 29 Twp. 14 R. 13-W

Well No. #10 Opdycke Farm \_\_\_\_\_

Skelly Company \_\_\_\_\_

(Hall) GURNEY

\_\_\_\_\_ Ft. from N. Line


330 Ft. from S. Line

660 Ft. from E. Line

\_\_\_\_\_ Ft. from W. Line

S 1/2 SE NW

Elv. 1764

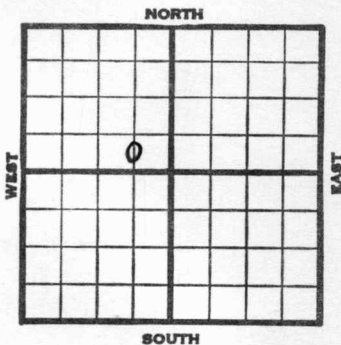

1939	REPORT
12/20	Location
12/28	Derrick.
1940	
1/4	10" - 253' WOC.
1/11	Drlg. 2469'
1/18	Lans. 2895' T.D. 2928'
	7" - 2927' RUST.
1/25	T.D. 2940' 5000 acid.
	Swab 143 bbls. in 5 hours.
1/31	Lans. 2895'
	7" - 2927'
	T.D. 2940'
	5000 acid.
	Pump 948 oil, plus 84 bbls. wtr.
	COMPLETED
	<del>O.W.W.O.</del> O.W.W.O.
1955	
8-31	OTD 2940
	7" @ 2926, DD
	5" @ 3167

OVER

1955  
8-31-

DD 3173, P/ 26 bopd, 93% wtr.  
PB 3015, 117/ 2995-3008 500 A  
S/ 5 bw 2 hr., PB 2957 105/ 2935-  
50, 3000 A  
S/ 1 bo 24 bw 6 hr.  
PB 2930, 54/ 2921-27  
S/ 15 bo 121 bw 7 hr., 42 / 2921-27  
1000 A  
S/ 95 bw 16 hr.  
PB 2916, 60/ 2901-11  
S/ 5 bo 220 bwpd  
PB 2870, 77/ 2853-64, 500 A  
L. 2901, R. 3172  
S/ 8 bw 7 hr. 63/ 2901-10 700 A  
S/ 14 bo 48 bw 9 hr.  
Comp. 15 bopd, 152 bw

FIRST REPORT

*✓*

COMPLETED

Map No. 72 Sec. 29 Twp. 14 R. 13W

Well No. 10 Opdycke

Skelly

Company

Contractor

FIRST REPORT

C S L SE NW

\_\_\_\_\_ Ft. from N. Line

330 Ft. from S. Line

660 Ft. from E. Line

\_\_\_\_\_ Ft. from W. Line

SECTION PLAT


HALL POOL

Location X

Rig up \_\_\_\_\_

Drilling and Remarks:

RECORD

Cased \_\_\_\_\_ in., \_\_\_\_\_ ft.

Sand \_\_\_\_\_

Gas \_\_\_\_\_

Oil \_\_\_\_\_

Total Depth \_\_\_\_\_

PRODUCTION

1st 24 hrs. Nat. \_\_\_\_\_

1st 24 hrs. after shot \_\_\_\_\_

Gas \_\_\_\_\_ Cu. Ft.

Dry Hole \_\_\_\_\_

Abandoned \_\_\_\_\_

Date

DEC 20 1939

19

S. J. LEWIS

Scout

Map No. 72 Sec. 29 Twp. 14 R. 13W

Well No. 10 Opkycke

Skelly Oil Company

Contractor

COMPLETED

SECTION PLAT

C S L SE NW

         Ft. from N. Line

330 Ft. from S. Line

660 Ft. from E. Line

         Ft. from W. Line


HALL POOL

Location                                 

Rig up                                 

Drilling and Remarks:

*Lans. 2895*  
*7" C 2927*  
*5000 acid*  
*Pump. 948 oil*  
*plus 84 1/2 gal water*

RECORD

Cased                  in.,                  ft.

Sand                                 

Gas                                 

Oil                                 

Total Depth 2940

PRODUCTION

1st 24 hrs. Nat.                                 

1st 24 hrs. after shot                                 

Gas                                  Cu. Ft.

Dry Hole                                 

Abandoned                                 

Date

JAN 31 1940 19

S. J. LEWIS

Scout

O.W.W.O.

FORM 513 REV. SUNRAY

OWWO

County Russell Elev. 1764  
 Sec. 29 Twp. 14 Rge. 13W  
 Company Skelly Oil  
 Farm Name W. Opdyke No. 10

TOPS	DEPTH	LOG	DATUM	Loc. in Sec.
Anh.				S $\frac{1}{2}$ SE NW
Tp.				
H.				
Tr.				
Dg.				
Bl.				
L.	2901			Geol.
K.C.				Contr.
B.K.C.				
Ce.				
C.				
M.				Pool
M.				Hall-Gurney
K.				
Mz.				
Me.				
V.				
S.				
S.				
A	3172			
R.				
Pe.				
G.				
T.D.				

FIRST REPORT  
 AUG 31 1955  
 COMPLETE

Date Comm. OTD 2940 7" @ 2926 DD 5" @ 3167  
DD 3173 P/ 26 bopd 93% wtr.  
PB 3015 117/ 2995-3008 500 A  
S/ 5 bw 2 hr. PB 2957 105/ 2935-50  
3000 A S/ 1 bo 2 $\frac{1}{4}$  bw 6 hr. PB 2930  
5 $\frac{1}{4}$ / 2921-27 S/ 15 bo 121 bw 7 hr.  
4 $\frac{1}{2}$ / 2921-27 1000 A S/ 95 bw 16 hr.  
PB 2916 60/ 2901-11 S/ 5 bo 220 bwpd  
PB 2870 77/ 2853-64 500 A

S/ 8 bw 7 hr. 63/ 2901-10 700 A  
S/ 14 bo 48 bw 9 hr.  
Comp. 15 bopd 152 bw

SEP 2 . 1955

Scout Cards	<i>Ag.</i>
Land Small Map	
Land Wall Map	
Tracings	
France Map	
Pine Map	
Misc.	