

KANSAS


Russell

Form 51-5M-7-39-Palace

Section 29 Township 14 Range 13 -W

Well No. #11 Opdycke

Company Skelly

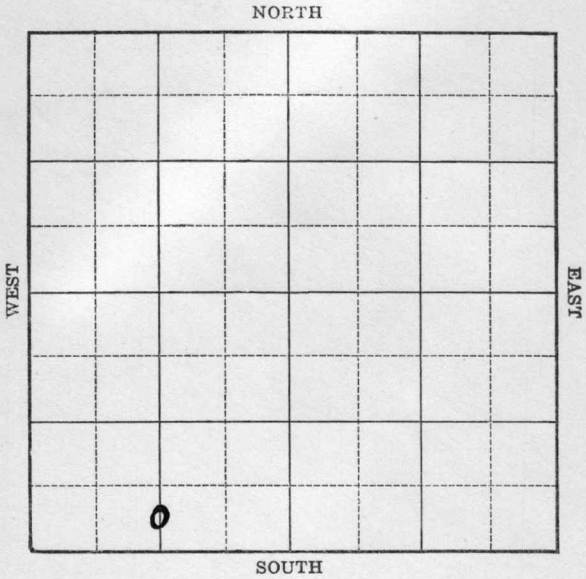

Sec. 29 Twp. 14 R. 13-W

Well No. #11 Opdycke Farm

Skelly Company

(Hall)


_____ Ft. from N. Line

330 Ft. from S. Line

_____ Ft. from E. Line

1320 Ft. from W. Line

Elev. 1714

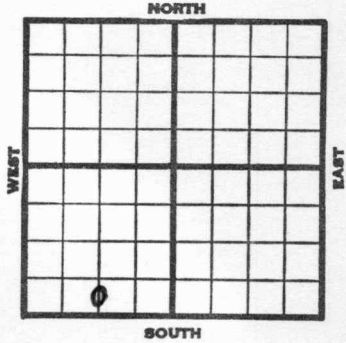

1940	REPORT
1/24	Location
2/1	Rotary.
2/8	"
2/15	10" - 285'
	Drilg. 1490'
2/23	Drilg. 2420'
2/29	Lans. 2843' Pay 2865-2866' T.D.
	7" - 2865' RUST.
3/6	Lansing 2843'
	7" - 2865'
	T.D. 2889' 7000 acid.
	Potential, pump 502 bbls.
	8% water.
	COMPLETED

Map No. 72 Sec. 29 Twp. 14 R. 13W

Well No. 11 Opdyoke

Skelly

Company

Contractor

C S L SW

SECTION PLAT

 Ft. from N. Line

330 Ft. from S. Line

 Ft. from E. Line

1320 Ft. from W. Line

HALL POOL

Location X

Rig up

Drilling and Remarks:

RECORD

Cased in., ft.

Sand

Gas

Oil

Total Depth

PRODUCTION

1st 24 hrs. Nat.

1st 24 hrs. after shot

Gas Cu. Ft.

Dry Hole

Abandoned

Date

JAN 24 1940 19

S. J. LEWIS

Scout

