


Section 29 Township 14 Range 13W

Well No. #18 Opdycke

Company Skelly Oil

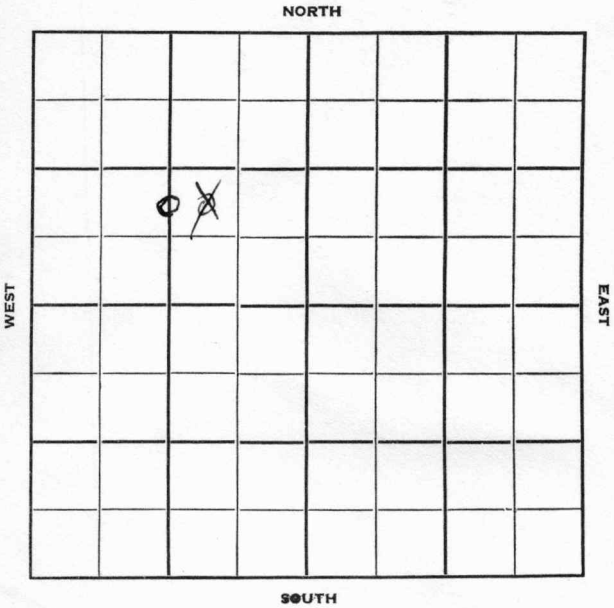

Russell

Sec. 29 Twp. 14 R. 13W ✓

Well No. #18 Opdycke Farm

Skelly Oil Company

Wentworth - Contr. Contractor

_____ Ft. from N. Line


990' Ft. from S. Line

~~990'~~ 1320 Ft. from E. Line

_____ Ft. from W. Line

~~NW SE NW~~

CNL S/2 NW

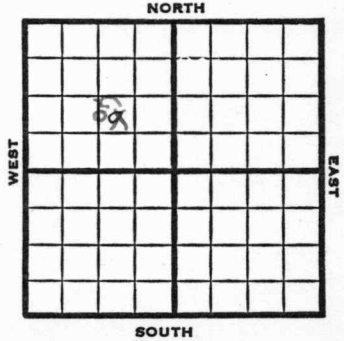

1950 Elev. 1763' REPORT

12/20 Spud 12-18-50
Drlg. 224'

3/14 Spud 12-18-50
Oil Well TD 3179'
Heeb. 2833' Toronto 2847'
Douglas 2864' Lans. 2900'
Gr sand 3174'
5" @ 3174
TD 3179 FU 2300' water SP 3170
16/3165-69 15/3166-70 300 A
B/2 gwph 750 A no inc. SP 3160
52/3147-52 750 A S/200 bw 5 hr.
SP 3110 59/3081-88 1000 A
S/150 bw 5 hr SP 3070
51/3045-54 1000 A SP 3035
72/2992-3000 1000 A S/15 bwph
SP 2985 12/2970-74
FU 600' water 10 min. SP 2960
12/2936-40 15/2943-48 FU 500' wtr
5 min. 36/2992-96 SP 2980 1000 A
S/12½ bo 139 bw 10 hr
72/2970-78 S/9 bwph SP 2962
45/2935-40 1000 A S/68 bo 400 bw
18 hr 36/2922-26 18/2929-31
1000 A S/77 bo 66 bw
P/4 bo 42 bw 23 hr. 2000 A SP 2877

OVER

(Information brought forward)

1951

3/14 54/2850-56 1000 A CO to 2861
48/2850-56 1000 A S/53 bo 23 bw
SP 2398 18/2336-42 4/2395-97
72/2336-61 S/11 bo 19 bw 11 hr
66/2288-2310 S/15 bo 16 bw 13 hr
P/18 bo 15 bw P/30 bo 15 bwpd
Comp. 29 bopd 20 bw

COMPLETED

Kansas

Map No. _____ Sec. 29 Twp. 14 R. 13W

Well No. 18 Opdycke


Skelly Oil Company

CORRECTION

Contractor

C N L S/2 NW

SECTION PLAT

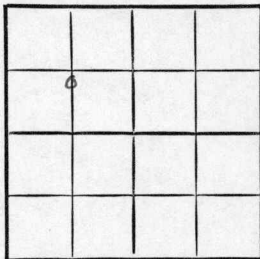

_____ Ft. from N. Line

990 Ft. from S. Line

1320 Ft. from E. Line

_____ Ft. from W. Line

Russell County

Location _____

Rig up _____

Drilling and Remarks:

Reported

NW SE NW

RECORD

Cased _____ in., _____ ft.

Sand _____

Gas _____

Oil _____

Total Depth _____

PRODUCTION

1st 24 hrs. Nat. _____

1st 24 hrs. after shot _____

Gas _____ Cu. Ft.

Dry Hole _____

Abandoned _____

Date

DEC 27 1950 19

J. E. TYRA Scout

County Russell State Kansas

Sec. 29 (Blk.) 14 (Sur. Rge.) 13W Map No.

Operator Skelly Oil

Well No. 18 Farm Opdycke

Elev. 1763 Location C N L S $\frac{1}{2}$ NW

990 Ft. From S Line NW

1320 Ft. From E Line Quarter

Ist. Report

Completion MAR 14 1951

Remarks

Wentworth - Contr.

Spudding Date 12-18-50

COMPLETE

Drlg. Data Oil well TD3179

Heeb. 2833 Toronto 2847 Douglas 2864

Lans. 2900 Gr. sand 3174 5" @ 3174

TD 3179 FU 2300' water SP 3170

16/ 3165-69 15/ 3166-70 300 A

B/ 2 gwph 750 A no inc. SP 3160

52/ 3147-52 750 A S/ 200 bw 5 hr.

SP 3110 59/ 3081-88 1000 A

S/ 150 bw 5 hr. SP 3070 51/ 3045-54

1000 A SP 3035 72/ 2992-3000 1000 A

S/ 15 bwph SP 2985 12/ 2970-74

FU 600' water 10 min. SP 2960

12/ 2936-40 15/ 2943-48 FU 500' water

5 min. 36/ 2992-96 SP 2980 1000 A

S/ 12 $\frac{1}{2}$ bo 139 bw 10 hr. 72/ 2970-78

J. E. TYRA

Drlg. Data

S/ 9 bwph SP 2962 45/ 2935-40 1000 A

S/ 68 bo 400 bw 18 hr. 36/ 2922-26

18/ 2929-31 1000 A S/ 77 bo 66 bw

P/ 4 bo 42 bw 23 hr. 2000 A SP 2877

54/ 2850-56 1000 A CO to 2861

48/ 2850-56 1000 A S/ 53 bo 23 bw

SP 2398 18/ 2336-42 4/ 2395-97

72/ 2336-61 S/ 11 bo 19 bw 11 hr.

66/ 2288-2310 S/ 15 bo 16 bw 13 hr.

P/ 18 bo 15 bw P/ 30 bo 15 bwpd

Comp. 29 bopd 20 bw

Scout Cards
Land Small Map
Land Wall Map
Trails
France Map
Pence Map
Misc.

6

MAR 19 1951