

KANSAS

Form 51-5M-7-40-Palace


Russell

Section 30 Township 14 Range 13²W

Well No. 5 Phinney

Company Coralena

NORTH Hall Gurney Lans.
Pool

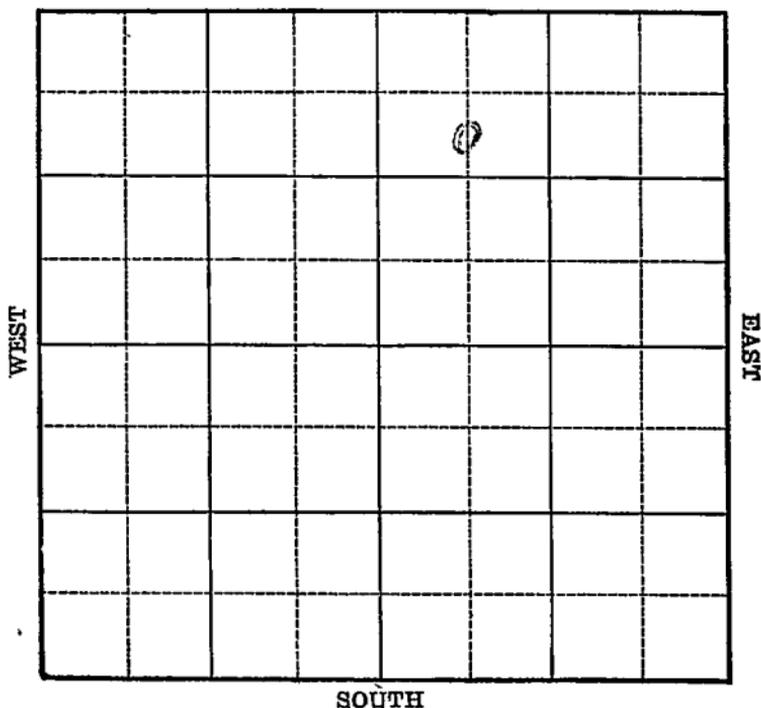

Sec. 30 Twp. 14 R. 13-W

Well No. #5 Phinney Farm

Coralena Company

(Hall Gurney Lans.)


990 Ft. from N. Line

_____ Ft. from S. Line

_____ Ft. from E. Line

660 Ft. from W. Line

Elev. 1750

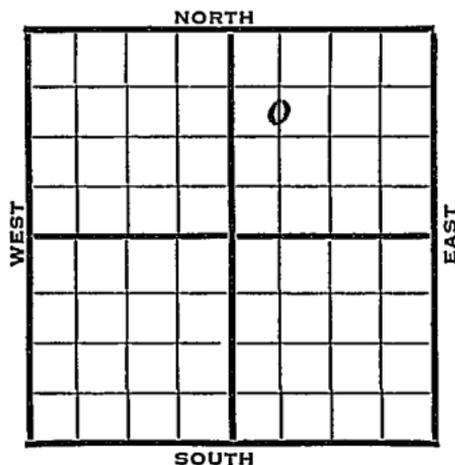

1941	REPORT
1/15	Location
1/23	Derrick.
1/30	"
2/6	"
2/13	10" - 200' Drlg. 650'
2/20	Lans. 2879-2937' T.D.
	7" - 2906' RUST.
2/27	T.D. 2980' 500' oil 12 hours.
3/6	12000 acid. Testing.
3/12	Lans. 2879'
	7" - 2906'
	T.D. 2980'
	12,000 acid.
	Potential 2811 oil & 4% water, pumping.
	38.3 Gravity
	COMPLETE

Map No. 72 Sec. 30 Twp. 14 R. 13WWell No. 5 PhinneyCoralena

Company

Contractor

FIRST REPORT

C S L NW NE

990 Ft. from N. Line

_____ Ft. from S. Line

_____ Ft. from E. Line

660 Ft. from W. Line

SECTION PLAT

		o	

HALL GURNEY LANS
Pool.Location X

Rig up _____

Drilling and Remarks:

RECORD

Cased _____ in., _____ ft.

Sand _____

Gas _____

Oil _____

Total Depth _____

PRODUCTION

1st 24 hrs. Nat. _____

1st 24 hrs. after shot _____

Gas _____ Cu. Ft.

Dry Hole _____

Abandoned _____

Date

JAN 15 1941 19S. J. LEWIS Scout

Map No. 72 Sec. 30 Twp. 14 R. 13WWell No. 5 PhinneyCoralena Company

Contractor

COMPLETED**SECTION PLAT**

C S L NW NE

990 Ft. from N. Line

_____ Ft. from S. Line

_____ Ft. from E. Line

660 Ft. from W. Line

HALL GURNEY LANS. POOL

		o	

Location _____

Rig up _____

Drilling and Remarks:

*Lane 2879**7" @ 2906**12000 cu. ft.**Pump 2811 oil + 4% H₂O*
*P.S.**353 Gr.***RECORD**

Cased _____ in., _____ ft.

Sand _____

Gas _____

Oil _____

Total Depth 2980**PRODUCTION**

1st 24 hrs. - Nat. _____

1st 24 hrs. after shot _____

Gas _____ Cu. Ft.

Dry Hole _____

Abandoned _____

Date

MAR 12 1941 19

S. J. LEWIS Scout