

KANSAS

Russell

Form 51—5M—7-40—Palace

Section 30 Township 14 Range 13-W

Well No. 7 Phinney


Company Coralena

Hall Gurney Pool

NORTH

WEST

EAST

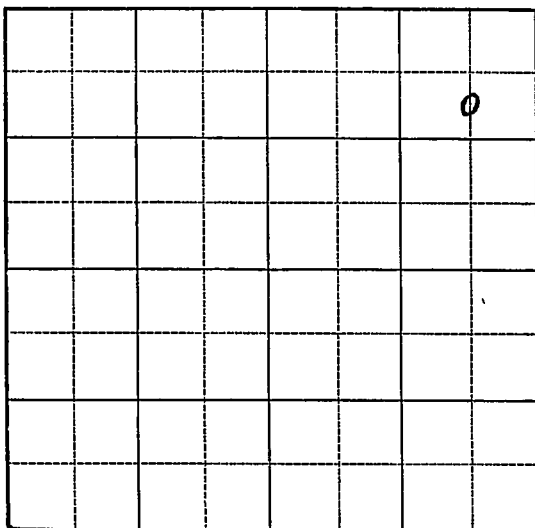


SOUTH

Sec. 30 Twp. 14 R. 13-WWell No. #7 Phinney FarmCoralena Company

(Hall Gurney)

990 Ft. from N. Line Ft. from S. Line66.0 Ft. from E. Line Ft. from W. Line

Elev. 1743

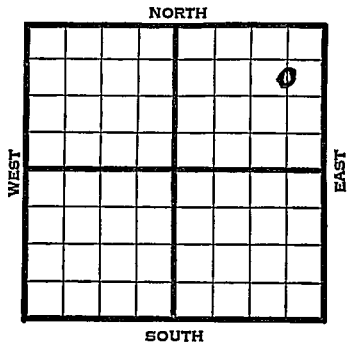

1941	REPORT
2/19	Location
2/27	Derrick.
3/6	10" - 220' WOC.
3/13	Drlg. 2700'
3/20	Lans. 2870' 7" - 2894'
	T.D. 2915' 200' oil.
3/27	" " " "
4/2	T.D. 2965' 1200' oil.
	12000 acid. On potential.
4/9	Lans. 2870'
	7" - 2894'
	T.D. 2965'
	12,000 acid.
	Potential 61 bbls., pump.
	3813 Gravity
	COMPLETED

Map No. _____ Sec. 30 Twp. 14 R. 13WWell No.: 7 PhinneyCoralena Company**FIRST REPORT** Contractor

C S L NE NE

990 Ft. from N. Line

_____ Ft. from S. Line

660 Ft. from E. Line

_____ Ft. from W. Line

SECTION PLAT

			o

HALL GURNEY POOLLocation X

Rig up _____

Drilling and Remarks:

RECORD

Cased _____ in., _____ ft.

Sand _____

Gas _____

Oil _____

Total Depth _____

PRODUCTION

1st 24 hrs. Nat. _____

1st 24 hrs. after shot _____

Gas _____ Cu. Ft.

Dry Hole _____

Abandoned _____

Date

FEB 19 1941 19 S. J. LEWIS Scout

Map No. 72 Sec. 30 Twp. 14 R. 13WWell No. 7 PhinneyCoralena CompanyCOMPLETED Contractor

C S L NE NE

990 Ft. from N. Line Ft. from S. Line660 Ft. from E. Line Ft. from W. Line

HALL GURNEY POOL

SECTION PLAT

			°

Location Rig up

Drilling and Remarks:

*Law 2870**7" @ 2894**12000 ac oil**Pump 61 P.S.**383 Gr.*

RECORD

Cased in., ft.Sand Gas Oil Total Depth 2965

PRODUCTION

1st 24 hrs. Nat. 1st 24 hrs. after shot Gas Cu. Ft.Dry Hole Abandoned

Date

APR 9 1941 19S. J. LEWIS Scout