


Map No. K11 Sec. 18 Twp. 29 R. 6  
Well No. 5 m. Canyon Farm  
Marble Hill Company

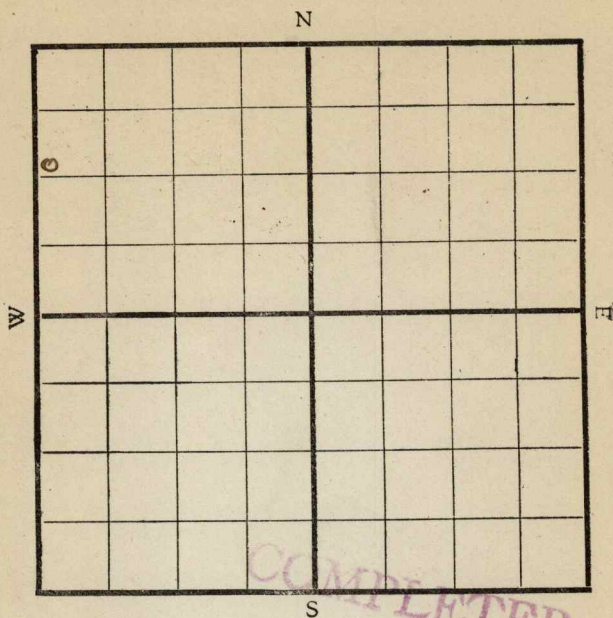

|      |                          |
|------|--------------------------|
| 6/4  | SD 250                   |
| 6/8  | UR 8 1/4 to 2200'        |
| 7/11 | UR 6" to 2600            |
| 24   | fishing 5" @ 2600'       |
| 8/4  | Run 5" @ 2600'           |
| 8/10 | SD @ 2600'               |
| 8/25 | 2741-47- 30/10 - SD 2760 |

Map No. K 11 Sec. 18 Twp. 29 R. 6Well No. 5 Mc CoyMarble Oil Company

Contractor

## SECTION PLAT

1070 Ft. from N. Line

----- Ft. from S. Line

----- Ft. from E. Line

200 Ft. from W. Line

|  |  |  |  |
|--|--|--|--|
|  |  |  |  |
|  |  |  |  |
|  |  |  |  |
|  |  |  |  |

FIRST REPORT

Location -----

Rig up -----

Drilling and Remarks:

D. O. @350'

## RECORD

Cased ----- in., ----- ft.

Sand -----

Gas -----

Oil -----

Total Depth -----

## PRODUCTION

1st 24 hrs. Nat. -----

1st 24 hrs. after shot -----

Gas ----- Cu. Ft.

Dry Hole -----

Abandoned -----

Date

5/4

191

Pyle

Scout

Map No. K11 Sec. 18 Twp. 29 R. 6Well No. 5 m-c CoyMarble Oil Company

Contractor

## SECTION PLAT

1070 Ft. from N. Line

Ft. from S. Line

Ft. from E. Line

200 Ft. from W. Line

|  |  |  |  |
|--|--|--|--|
|  |  |  |  |
|  |  |  |  |
|  |  |  |  |
|  |  |  |  |

COMPLETED

Location

Rig up

Drilling and Remarks:

Shot 30 qts

## RECORD

Cased \_\_\_\_\_ in., \_\_\_\_\_ ft.

Sand 2741-47

Gas \_\_\_\_\_

Oil \_\_\_\_\_

Total Depth 2760

## PRODUCTION

1st 24 hrs. Nat. \_\_\_\_\_

1st 24 hrs. after shot 10 bbls

Gas \_\_\_\_\_ Cu. Ft.

Dry Hole \_\_\_\_\_

Abandoned \_\_\_\_\_

Date

8/25 19120

Pyle

Scout