


KANSAS

Barton

Section 19 Township 16 Range 13-~~W~~Well No. #1 SusankCompany Bartlett & ~~Spr~~ Vernon Oil + Gas

Susank Pool

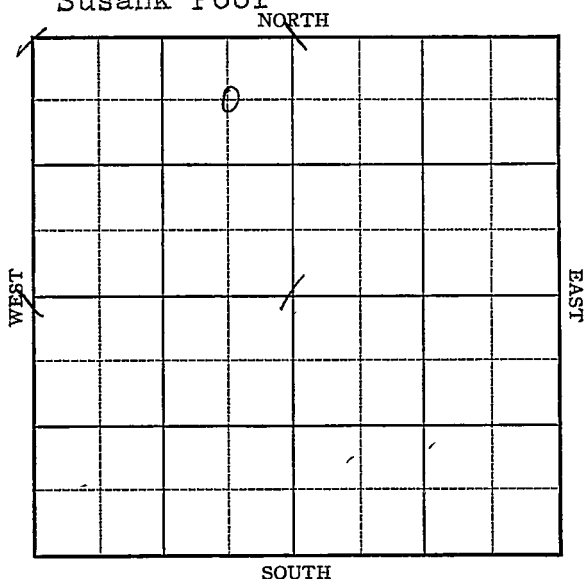

KANSAS

Barton

Sec. 19 Twp. 16 R. 13-W

Well No. #1 Susank Farm
Bartlett & ~~Grum~~ Vernon Oil & Gas. Company


Susank Pool

660 Ft. from N. Line

Ft. from S. Line

660 Ft. from E. Line

Ft. from W. Line

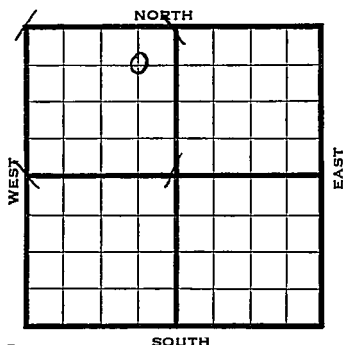

C NE NW E. 1943

1942

REPORT

11/18	Derrick
11/24	440' fsg. bailer
12/2	16" @ 370 13" @ 1563 Anhy 906 10" @ 910 Drlg. 1535
12/8	Ft. Riley 1485 Neva 2220 8" @ 2255 Drlg. 2275
12/16	Topeka 2845 Drlg. 3140
12/22	Lans 3162 7" @ 3162' TD 3362' Water SD
12/29	Sooy 3407 Drlg. 3443
1943	
1/6	Arb. 3445 No shows T.D. 3455

ABANDONED

Barton

KANSAS

Map No. 73 Sec. 19 Twp. 16 R. 13WWell No. 1 Susank

Bartlett & Crum

Company

FIRST REPORT

Contractor

C NE NW


660 Ft. from N. Line

Ft. from S. Line

660 Ft. from E. Line

Ft. from W. Line

SECTION PLAT

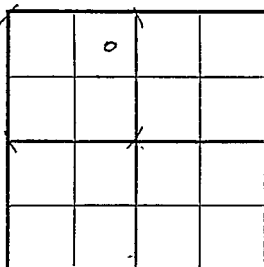

SUSANK POOL

Location

Rig up

Drilling and Remarks:

Derrick

RECORD

Cased _____ in., _____ ft.

Sand _____

Gas _____

Oil _____

Total Depth _____

PRODUCTION

1st 24 hrs. Nat. _____

1st 24 hrs. after shot _____

Gas _____ Cu. Ft.

Dry Hole _____

Abandoned _____

Date

NOV 1 8 1942 19

S. I. LEWIS

Scout

Map No. 73 Sec. 19 Twp. 16 R. 13WWell No. 1 ["]SusankBartlett & Vernon Oil & Gas
Company

Contractor

C NE NW


660 Ft. from N. Line

Ft. from S. Line

660 Ft. from E. Line

Ft. from W. Line

SECTION PLAT

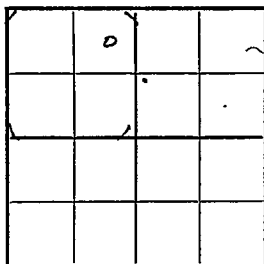

SUSANK POOL

Location

Rig up

Drilling and Remarks:

Reported

Bartlett & Crum 1st 24 hrs. Nat. _____

1st 24 hrs. after shot _____

Gas _____ Cu. Ft.

Dry Hole _____

Abandoned _____

RECORD

Cased _____ in., _____ ft.

Sand _____

Gas _____

Oil _____

Total Depth _____

PRODUCTION

Date

NOV 24 1942 19

S. J. LEWIS Scout

Barton

KANSAS
 Map No. 73 Sec. 19 Twp. 16 R. 13W

Well No. 1 Susank

Bartlett & Vernon Oil Company
& Gas
ABANDONED Contractor

C NE NW

660 Ft. from N. Line

Ft. from S. Line

660 Ft. from E. Line

Ft. from W. Line

SECTION PLAT

	o		

SUSANK POOL

Location _____

Rig up _____

Drilling and Remarks:

*Ce X 3445**No shows*

RECORD

Cased _____ in., _____ ft.

Sand _____

Gas _____

Oil _____

Total Depth 3455

PRODUCTION

1st 24 hrs. Nat. _____

1st 24 hrs. after shot _____

Gas _____ Cu. Ft.

Dry Hole _____

Abandoned _____

Date

JAN 6 1943 19S. I. LEWIS Scout