

KANSAS Barton

FORM 51 5M 4-41 PETROL


Section 19 Township 16 Range 13-W

Well No. #1 Susank

Company Derby

Trapp Pool

NORTH

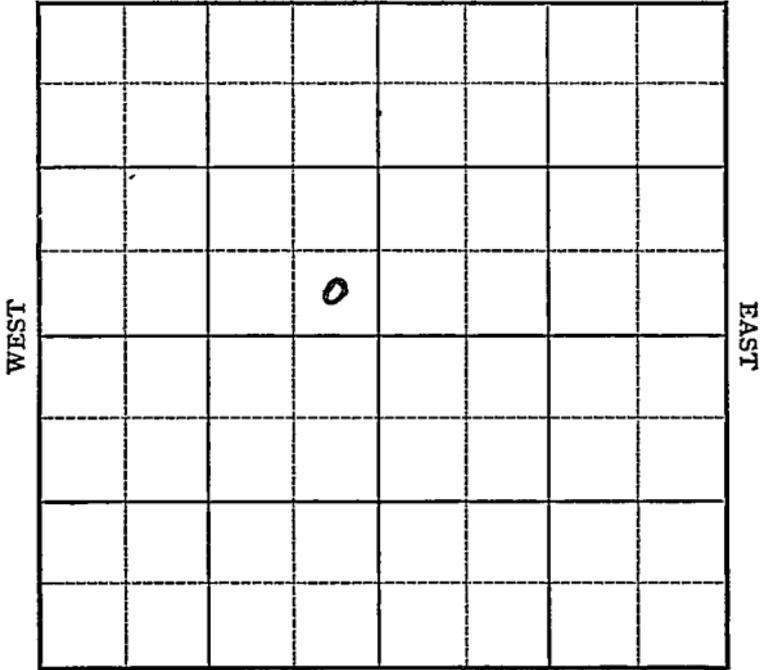

SOUTH

Sec. 19 Twp. 16 R. 13-W

Well No. #1 Susank Farm

Derby Company

(Trapp)


 Ft. from N. Line

330 Ft. from S. Line

330 Ft. from E. Line

 Ft. from W. Line

Elev. 1942

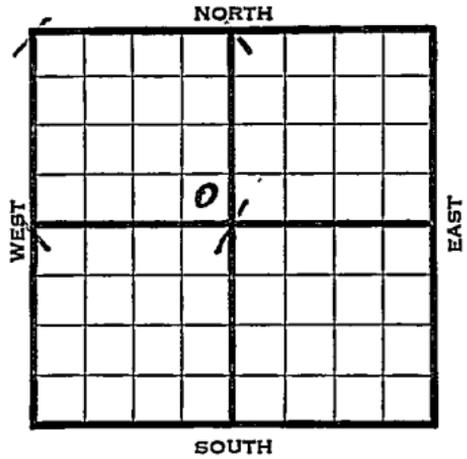

1942	REPORT
6/17	Location
6/24	8" - 660' WOC.
7/1	Drlg. 2910'
7/8	Topeka 2860'
	Lans. 3169'
	Arb. 3410'
	T.D. 3439'
	No shows.
	ABANDONED

Map No. 23 Sec. 19 Twp. 16 R. 13W

Well No. 1 Susank


Derby Company

FIRST REPORT

Contractor

SE NW

SECTION PLAT

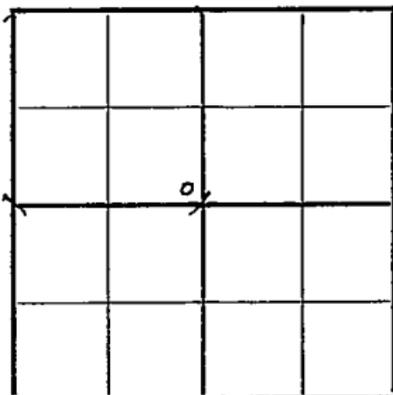

_____ Ft. from N. Line

330 Ft. from S. Line

330 Ft. from E. Line

_____ Ft. from W. Line

TRAPP POOL

Location XXX

Rig up _____

Drilling and Remarks:

RECORD

Cased _____ in., _____ ft.

Sand _____

Gas _____

Oil _____

Total Depth _____

PRODUCTION

1st 24 hrs. Nat. _____

1st 24 hrs. after shot _____

Gas _____ Cu. Ft.

Dry Hole _____

Abandoned _____

Date

JUN 17 1942 19

S. J. LEWIS Scout

Barton

KANSAS

Map No. 73 Sec. 19 Twp. 16 R. 13W

Well No. 1 Susank

Derby Company

ABANDONED

Contractor

SECTION PLAT

SE NW

_____ Ft. from N. Line

330 Ft. from S. Line

330 Ft. from E. Line

_____ Ft. from W. Line

TRAPP POOL

Location _____

Rig up _____

Drilling and Remarks:

Top ka 2860

Liams 3169

Br 3416

Noe lows

RECORD

Cased _____ in., _____ ft.

Sand _____

Gas _____

Oil _____

Total Depth 3439

PRODUCTION

1st 24 hrs. Nat. _____

1st 24 hrs. after shot _____

Gas _____ Cu. Ft.

Dry Hole _____

Abandoned _____

Date

JUL 8 1942 19

S. J. LEWIS

Scout