


Section 29 Township 14 Range 13-W

Well No. 3 Rogg

Company Sinclair Prairie

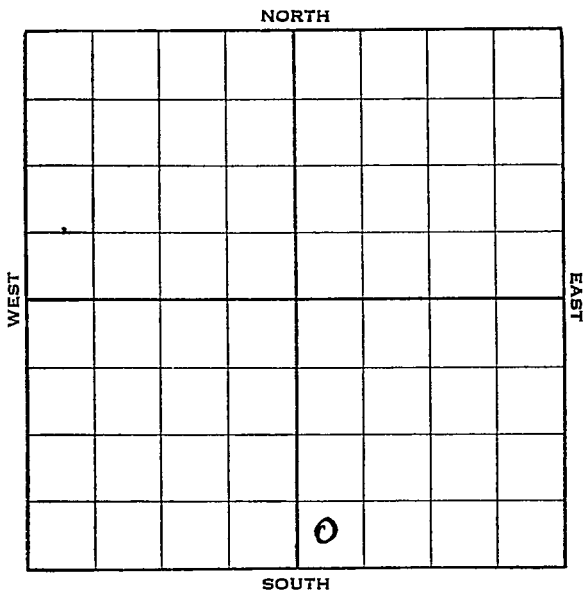

1938

10/24--Top Lansing 2864 T.D. 2908

2000 gallons acid

15,000 gallons acid

Took potential:

1st hour flow 40 bbls.

2nd " " 37 "

3rd " " 35 "

4th " " 26 "

5th " " 20 "

6th " " 17 "

7th " " 17 "

8th " " 31 "

24 hour potential 670 bbls. flow (Tel)

10/26 7" = 2892'.

Lans. 2864'.

T. D. 2908'.

17,000 acid.

Flowed 223 bbls. 8 hrs.

Potential 670 bbls.

COMPLETED

Map No. 72 Sec. 29 Twp. 14 R. 13W

Well No. 3 Rogg

Sinclair Prairie

Company

Contractor

FIRST REPORT

SW SE

SECTION PLAT

 Ft. from N. Line

330 Ft. from S. Line

 Ft. from E. Line

330 Ft. from W. Line

Special
offset

Location X

Rig up

Drilling and Remarks:

MT

RECORD

Cased in. ft.

Sand

Gas

Oil

Total Depth

PRODUCTION

1st 24 hrs. Nat.

1st 24 hrs. after shot

Gas Cu. Ft.

Dry Hole

Abandoned

Date

SEP 21 1930

19

H. D. Hatfield

Scout

Map No. _____ Sec. 29 Twp. 14 R. 13W

Well No. 3-Rogg

Sinclair Prairie Company

Contractor _____

COMPLETED

SW SE

SECTION PLAT

_____ Ft. from N. Line

330 Ft. from S. Line

_____ Ft. from E. Line

330 Ft. from W. Line

Location _____

Rig up _____

Drilling and Remarks:

17,000 acid.

Flowed 22 3/8

POT 670

RECORD

Cased 7 in., 2892 ft.

Sand LEN 5 2864

Gas _____

Oil _____

Total Depth 2908

PRODUCTION

1st 24 hrs. Nat. _____

1st 24 hrs. after shot _____

Gas _____ Cu. Ft.

Dry Hole _____

Abandoned _____

Date

OCT 26 1925 19

H. D. Hatfield

Scout