


Section 29 Township 14 Range 13-W

Well No. 2 Rogg

Company Sinclair-Prairie

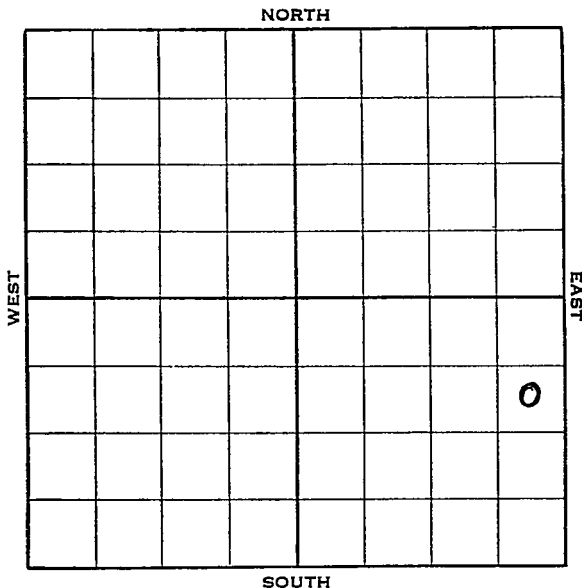

Sec. 29 Twp. 14 R. 13-W

Well No. #2 Rogg Farm


Sinclair-Prairie Company

990 Ft. from N. Line

         Ft. from S. Line

330 Ft. from E. Line

         Ft. from W. Line

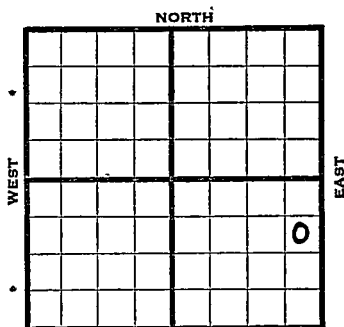

Elev. 1751 SE-NESE

1938	REPORT	
4/27	B.R.R.	
5/6	12" @ 144'. WOC.	
5/12	Drlg. 1725'.	
5/20	Kansas City 2886 7" 2911 1/2 T.D.	
	No shows Rust	
5/27	" " " "	
5/27	Kansas City 2886 7" 2911 1/2	
	First oil 2922 T.D. 2930	
	Filled up 970' oil 1st 8 hrs. No water	
	Acidized 8000 gallons No test yet	
	Building tanks (Tel)	
	Running 3' lower on K.C. than Sinclair-Prairie	
	#1 Rogg north offset completed for 760 bbls.	
5/31	Pumped 330 bbls. oil in 18 hours	
	Will take potential (Tel)	
6/3	SD for tanks.	
6/10	Pump 178 bbls. in 4 hrs & 181 bbls. in 4 hrs.	
	Will reacidize.	
6/17	" " "	

OVER

1938

6/18--15,000 acid. (Making a total of  
23,000 gallons)

Pumped 177 bbls. in 4 hours &  
204 bbls. last 4 hours.

Potential 1063 bbls. No water.

(Letter from H.D.H.)

6/22 8" @ 2911 $\frac{1}{2}$ '.

K. C. 2886'

T. D. 2930'

23,000 acid.

Pumped 177 bbls. 4 hrs. &  
204 bbls. 4 hours.

Potential 1063 bbls.

No water.

COMPLETED

Map No. 72 Sec. 29 Twp. 14 R. 13WWell No. 2 RoggSinclair Prairie

Company

Contractor

## FIRST REPORT

## SECTION PLAT

SE NE SE

990 Ft. from N. Line

\_\_\_\_\_ Ft. from S. Line

330 Ft. from E. Line

\_\_\_\_\_ Ft. from W. Line

			0

Location \_\_\_\_\_

Rig up \_\_\_\_\_

Drilling and Remarks:

BRR

## RECORD

Cased \_\_\_\_\_ in \_\_\_\_\_ ft.

Sand \_\_\_\_\_

Gas \_\_\_\_\_

Oil \_\_\_\_\_

Total Depth \_\_\_\_\_

## PRODUCTION

1st 24 hrs. Nat. \_\_\_\_\_

1st 24 hrs. after shot \_\_\_\_\_

Gas \_\_\_\_\_ Cu. Ft.

Dry Hole \_\_\_\_\_

Abandoned \_\_\_\_\_

Date

APR 27 1938 19

H. D. Hatfield

Scout

Russell KANSAS

Map No. 72 Sec. 29 Twp. 14 R. 13WWell No. 2 RoggSindlair Prairie

Company

Contractor

**COMPLETED****SECTION PLAT**990 SE NE SE  
Ft. from N. Line

Ft. from S. Line

330 Ft. from E. Line

Ft. from W. Line

			0

Location \_\_\_\_\_

Rig up \_\_\_\_\_

Drilling and Remarks:

*23,000 acid**Pumped 177/4 x 204/4**POT 1063**No water***RECORD**Cased 8 in., 2911 1/2 ft.Sand H.C. 2886

Gas \_\_\_\_\_

Oil \_\_\_\_\_

Total Depth 2930**PRODUCTION**

1st 24 hrs. Nat. \_\_\_\_\_

1st 24 hrs. after shot \_\_\_\_\_

Gas \_\_\_\_\_ Cu. Ft.

Dry Hole \_\_\_\_\_

Abandoned \_\_\_\_\_

Date

JUN 22 1938

19

H. D. Hatfield

Scout