

KANSAS


Russell

Form 51—5M—11-38—Palace

Section 29 Township 14 Range 13-W

Well No. #6 Rogg

Company Sinclair-Prairie

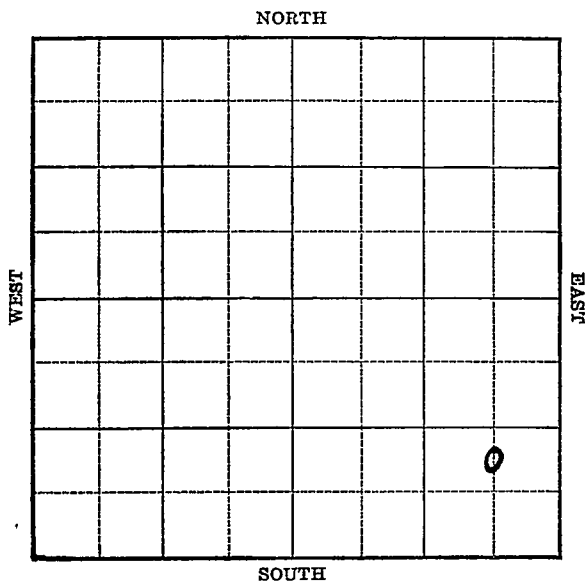

KANSAS


Russell

Sec. 29 Twp. 14 R. 13-WWell No. #6 Rogg FarmSinclair-Prairie Company

(Hall)

 Ft. from N. Line990 Ft. from S. Line660 Ft. from E. Line Ft. from W. Line

Elev. 1737

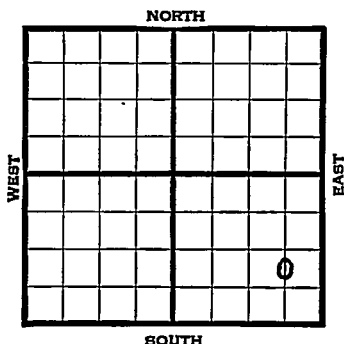

1939	REPORT
7/19	Rotary rig.
7/27	"
8/3	10" - 145' Drlg. 2200'
8/10	Lans. 2867' Gorham 3147'
	T.D. 3150' 7" - 3147' RUST.
8/17	89 shots 2902-12'
	2000 acid. Pump 6 bbls. oil
	per hour. 8000 acid.
	Pump 102 bbls. water 19 hours.
8/24	Shut down.
8/31	Shut down.
9/6	Lans. 2869'
	Gorham 3147'
	7" - 3147'
	T.D. 3150'
	8000 acid.
	Water with S.O.
	ABANDONED

Map No. 72 Sec. 29 Twp. 14 R. 13WWell No. 6 RoggSinclair Prairie

Company

Contractor

FOOT REPORT

SECTION PLAT

C N L SE SE

 Ft. from N. Line990 Ft. from S. Line660 Ft. from E. Line Ft. from W. Line

HALL POOL

Location Rig up

Drilling and Remarks:

Rotary Rig.

RECORD

Cased in., ft.Sand Gas Oil Total Depth

PRODUCTION

1st 24 hrs. Nat. 1st 24 hrs. after shot Gas Cu. Ft.Dry Hole Abandoned

Date

13 193919

Scout

Russell **KANSAS**Map No. 72 Sec. 29 Twp. 14 R. 13WWell No. 6 RoggSinclair Prairie Company

Contractor

**ABANDONED
C N L SE SE****SECTION PLAT**

			o

 Ft. from N. Line990 Ft. from S. Line660 Ft. from E. Line Ft. from W. Line**HALL POOL**Location Rig up

Drilling and Remarks:

*Loss 2869**Loss 3147**7" @ 3147**8000 @ 3147**Water 80.***RECORD**Cased in., ft.Sand Gas Oil Total Depth 2150**PRODUCTION**1st 24 hrs. Nat. 1st 24 hrs. after shot Gas Cu. Ft.Dry Hole Abandoned

Date

SEP 6 1939 19

S. J. LEWIS Scout