


Section 30 Township 14 Range 13-W

Well No. #28 E. Miller

Company J. J. Hall
(Hall Gurney)

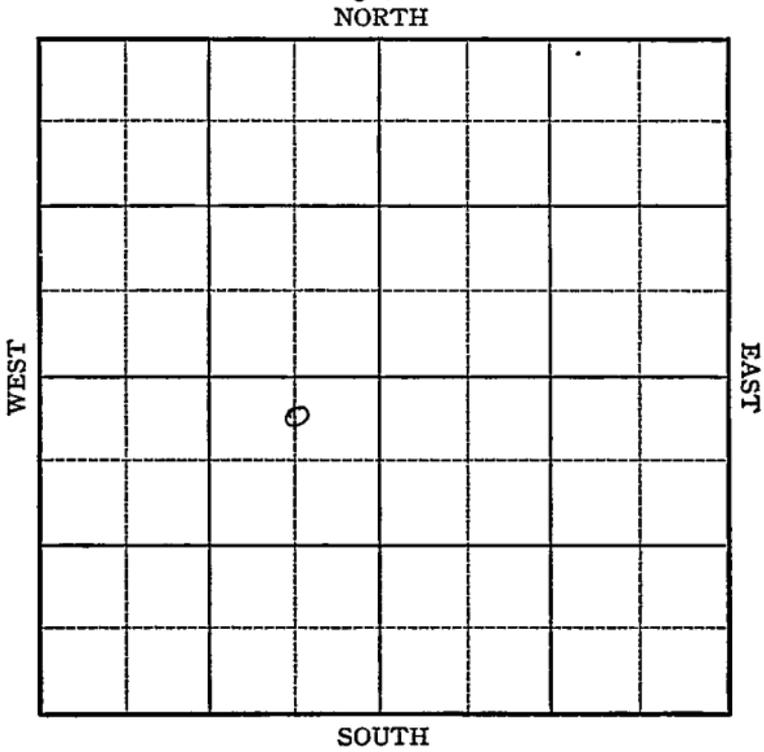

Sec. 30 Twp. 14 R. 13-W

Well No. #28 E. Miller Farm

J. J. Hall Company

(Hall Gurney)


330 Ft. from N. Line

_____ Ft. from S. Line

660 Ft. from E. Line

_____ Ft. from W. Line

Elev. 1712

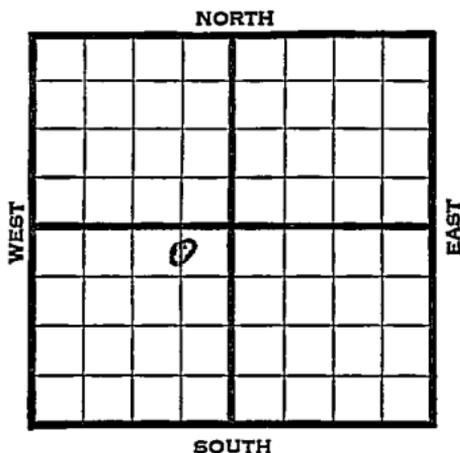

1941	REPORT
7/23	Derrick
7/31	10" @ 225 WOC
8/7	" " "
8/15	Drlg. 1950'
8/21	Lans. 2840' 5" - 2850' T.D.
	RUST.
8/28	"
9/4	"
9/11	T.D. 2940'
	Potential 1341 bbls., pump.
9/17	Lans. 2840'
	5" - 2850'
	T.D. 2940'
	8000 acid.
	Potential 1341 bbls., pump.
	38.3 Gravity
	COMPLETED

Map No. _____ Sec. 30 Twp. 14 R. 13WWell No. 28 E. MillerJ. J. Hall

Company

FIRST REPORT

Contractor

SECTION PLAT

C N L NE SW

330 Ft. from N. Line

_____ Ft. from S. Line

660 Ft. from E. Line

_____ Ft. from W. Line

	o		

HALL GURNEY POOL

Location _____

Rig up _____

Drilling and Remarks:

Derrick

RECORD

Cased _____ in., _____ ft.

Sand _____

Gas _____

Oil _____

Total Depth _____

PRODUCTION

1st 24 hrs. Nat. _____

1st 24 hrs. after shot _____

Gas _____ Cu. Ft.

Dry Hole _____

Abandoned _____

Date

JUL 23 1941

19

S. J. LEWIS Scout

Map No. _____ Sec. 30 Twp. 14 R. 13W

Well No. 28 E. Miller

J. J. Hall Company

COMPLETED Contractor

SECTION PLAT

C N L NE SW

	o		

330 Ft. from N. Line

_____ Ft. from S. Line

660 Ft. from E. Line

_____ Ft. from W. Line

HALL GURNEY POOL

Location _____

Rig up _____

Drilling and Remarks:

*Lease 2840
5" @ 2850
8000 acial
Pump 1341
38 3/4*

RECORD

Cased _____ in., _____ ft.

Sand _____

Gas _____

Oil _____

Total Depth 2940

PRODUCTION

1st 24 hrs. Nat. _____

1st 24 hrs. after shot _____

Gas _____ Cu. Ft.

Dry Hole _____

Abandoned _____

Date

SEP 17 1941 19

S. J. LEWIS Scout