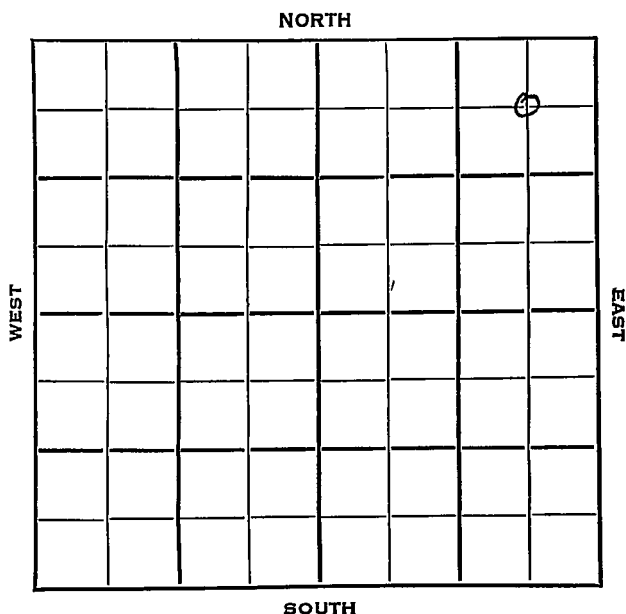


Section 30 Township 14 Range 13WWell No. #13 PhinneyCompany CRA

Russell KANSAS ✓

Sec. 30 Twp. 14 R. 13 WWell No. # 13 Phinney FarmC R A

Company

Schaffer Drlg.

Contractor

Hall-Gurney Pool660

Ft. from N. Line


Ft. from S. Line

660

Ft. from E. Line

Ft. from W. Line

C NE NE

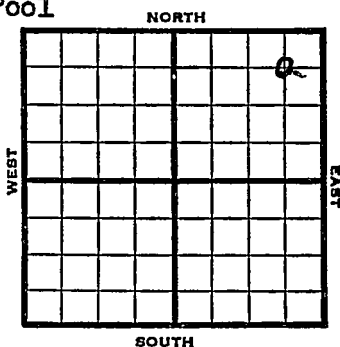

1953

Elev. 1741' REPORT

9/2

Sellar & Pits

9/9

10" @ 684
Drlg. 1991'


9/16

NR

10/7

Spud 9-4-53 Oil well TD 3147
 10" @ 684 Heeb 2804 Tor. 2822'
 Doug. 2836' KC 2871 SO 2908-16
 Regan 3145 TD 3147 7" @ 3145
 CO to 3147 FU 2600' oil 20 min
 P/112 BO 13½ hr. P/101 BO 12 hr.
 P/67 BO 36 BW 12 hr. P/31 BW 21 BO
 8 hr.
 Comp. 131 BOPD 76 BW

COMPLETED

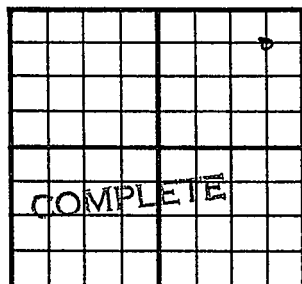County Russell State KansasSec. 30 (Blk. 14) (Sur. 13W) Map No. 13WOperator C R AWell No. 13 Farm PhinneyElev. 1741 Location C NE NE660 Ft. From N Line NE660 Ft. From E Line Quarter

1st. Report

Completion OCT 7 1953Remarks Hall-Gurney PoolSchaffer Drlg. - Contr.Spudding Date 9-4-53Drlg. Data Oil well TD 314710" @ 684 Heeb. 2804 Tor. 2822Doug. 2836 KC 2871 SO 2908-16Regan 3145 TD 3147 7" @ 3145CO to 3147 FU 2600' oil 20 min.P/ 112 bo 13 $\frac{1}{2}$ hr. P/ 101 bo 12 hr.P/ 67 bo 36 bw 12 hr. P/ 31 bw 21 bo8 hr. Comp. 131 bopd 76 bw