

# KANSAS

FORM 51 25M 3-49 PETROLEUM

Russell

Section 29 Township 14 Range 13W

Well No. 8 Rogg

Company Sinclair Oil & Gas

Hall-Gurney

NORTH

WEST

EAST

							0

SOUTH

Sec. 29 Twp. 14 R. 13W

Well No. #8 Rogg Farm \_\_\_\_\_  
 Sinclair Oil & Gas Company  
 Hall-Gurney Pool


\_\_\_\_\_ Ft. from N. Line

330' Ft. from S. Line

330' Ft. from E. Line

\_\_\_\_\_ Ft. from W. Line

SE/C

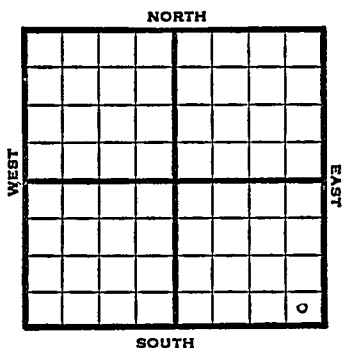

1949- Elev. 1731' REPORT

- 9/21 Location
- 9/28 "
- 10/5 10" @ 144'  
Drlg 1665'
- 10/12 Tarkio 2241'  
7" @ 2241  
Drlg 2276'  
VSSO
- 10/19 TD 2288'  
PB 2250'  
40 qts 2243-50  
-VSSO
- 10/26 Tarkio 2241'  
7" @ 2241'  
40 qts - 150 acid  
Pump 20 oil Pot.  
Gr. 39°  
TD 2288'

**COMPLETED**

Map No. \_\_\_\_\_ Sec. 29 Twp. 14 R. 13W

Well No. 8 Rogg

Sinclair Oil & Gas Company

Contractor

SE/C

FIRST REPORT  
SECTION PLAT


\_\_\_\_\_ Ft. from N. Line

330 \_\_\_\_\_ Ft. from S. Line

330 \_\_\_\_\_ Ft. from E. Line

\_\_\_\_\_ Ft. from W. Line

Russell County

Location X

Rig up

Drilling and Remarks:

RECORD

Cased \_\_\_\_\_ in., \_\_\_\_\_ ft.

Sand \_\_\_\_\_

Gas \_\_\_\_\_

Oil \_\_\_\_\_

Total Depth \_\_\_\_\_

PRODUCTION

1st 24 hrs. Nat. \_\_\_\_\_

1st 24 hrs. after shot \_\_\_\_\_

Gas \_\_\_\_\_ Cu. Ft.

Dry Hole \_\_\_\_\_

Abandoned \_\_\_\_\_

Date

SEP 21 1949 19

S. J. LEWIS Scout

Kansas

Hall-Gurney Pool

Map No. \_\_\_\_\_ Sec. 29 Twp. 14 R. 13W

Well No. 8 Rogg

Sinclair Oil &amp; Gas

Company

COMPLETE

Contractor

SE/C

E. 11231  
SECTION PLAT

			6

\_\_\_\_\_ Ft. from N. Line

330 Ft. from S. Line

330 Ft. from E. Line

\_\_\_\_\_ Ft. from W. Line

Russell County

Location \_\_\_\_\_

Rig up \_\_\_\_\_

Drilling and Remarks:

*Hard bit 2241**7" @ 2241**409 ft - 1500 acid**Run 20 oil BX**39°/hr*

## RECORD

Cased \_\_\_\_\_ in., \_\_\_\_\_ ft.

Sand \_\_\_\_\_

Gas \_\_\_\_\_

Oil \_\_\_\_\_

Total Depth *409 ft.*

## PRODUCTION

1st 24 hrs. Nat. \_\_\_\_\_

1st 24 hrs. after shot \_\_\_\_\_

Gas \_\_\_\_\_ Cu. Ft.

Dry Hole \_\_\_\_\_

Abandoned \_\_\_\_\_

Date

OCT 26 1949 19

S. J. LEWIS

Scout